

UNITED STATES
DEPARTMENT OF THE INTERIOR
BUREAU OF LAND MANAGEMENT

SECTION


14

SE 1/4 SE 1/4

Oregon State Water Filings

TOWNSHIP 28 S, RANGE 17 E, W. M.

North Tied in with aerial photo and OSMD Quad Maps

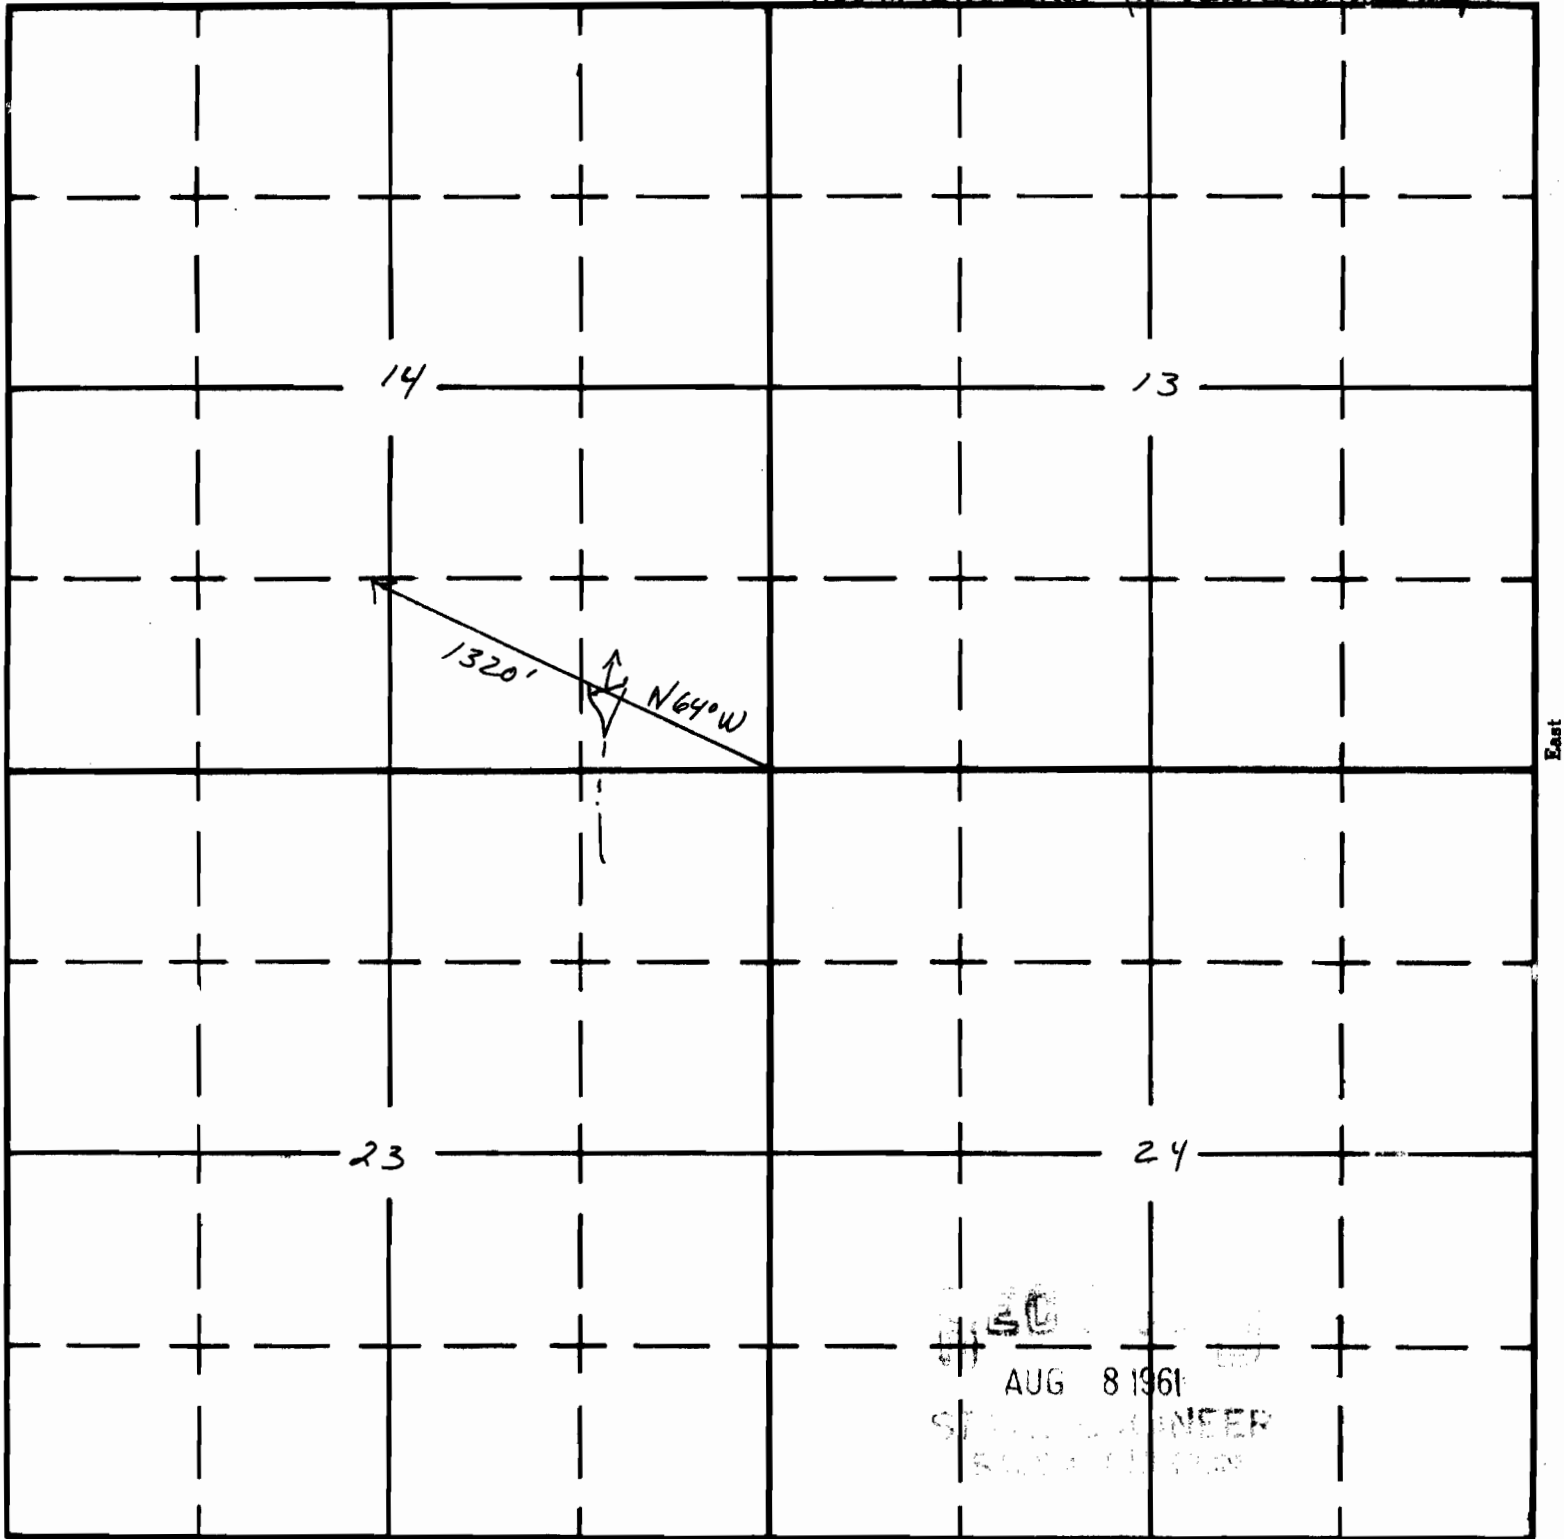

REC
AUG 8 1961

APPLICATION No. **R-36550**
PERMIT No. **R 7233**