

UNITED STATES
DEPARTMENT OF THE INTERIOR
BUREAU OF LAND MANAGEMENT

SECTION


5

NW 1/4 NE 1/4

Oregon State Water Filings

TOWNSHIP 29S, RANGE 17E, W. M.

North *Tied in with aerial photo and OSHP Quad Maps*

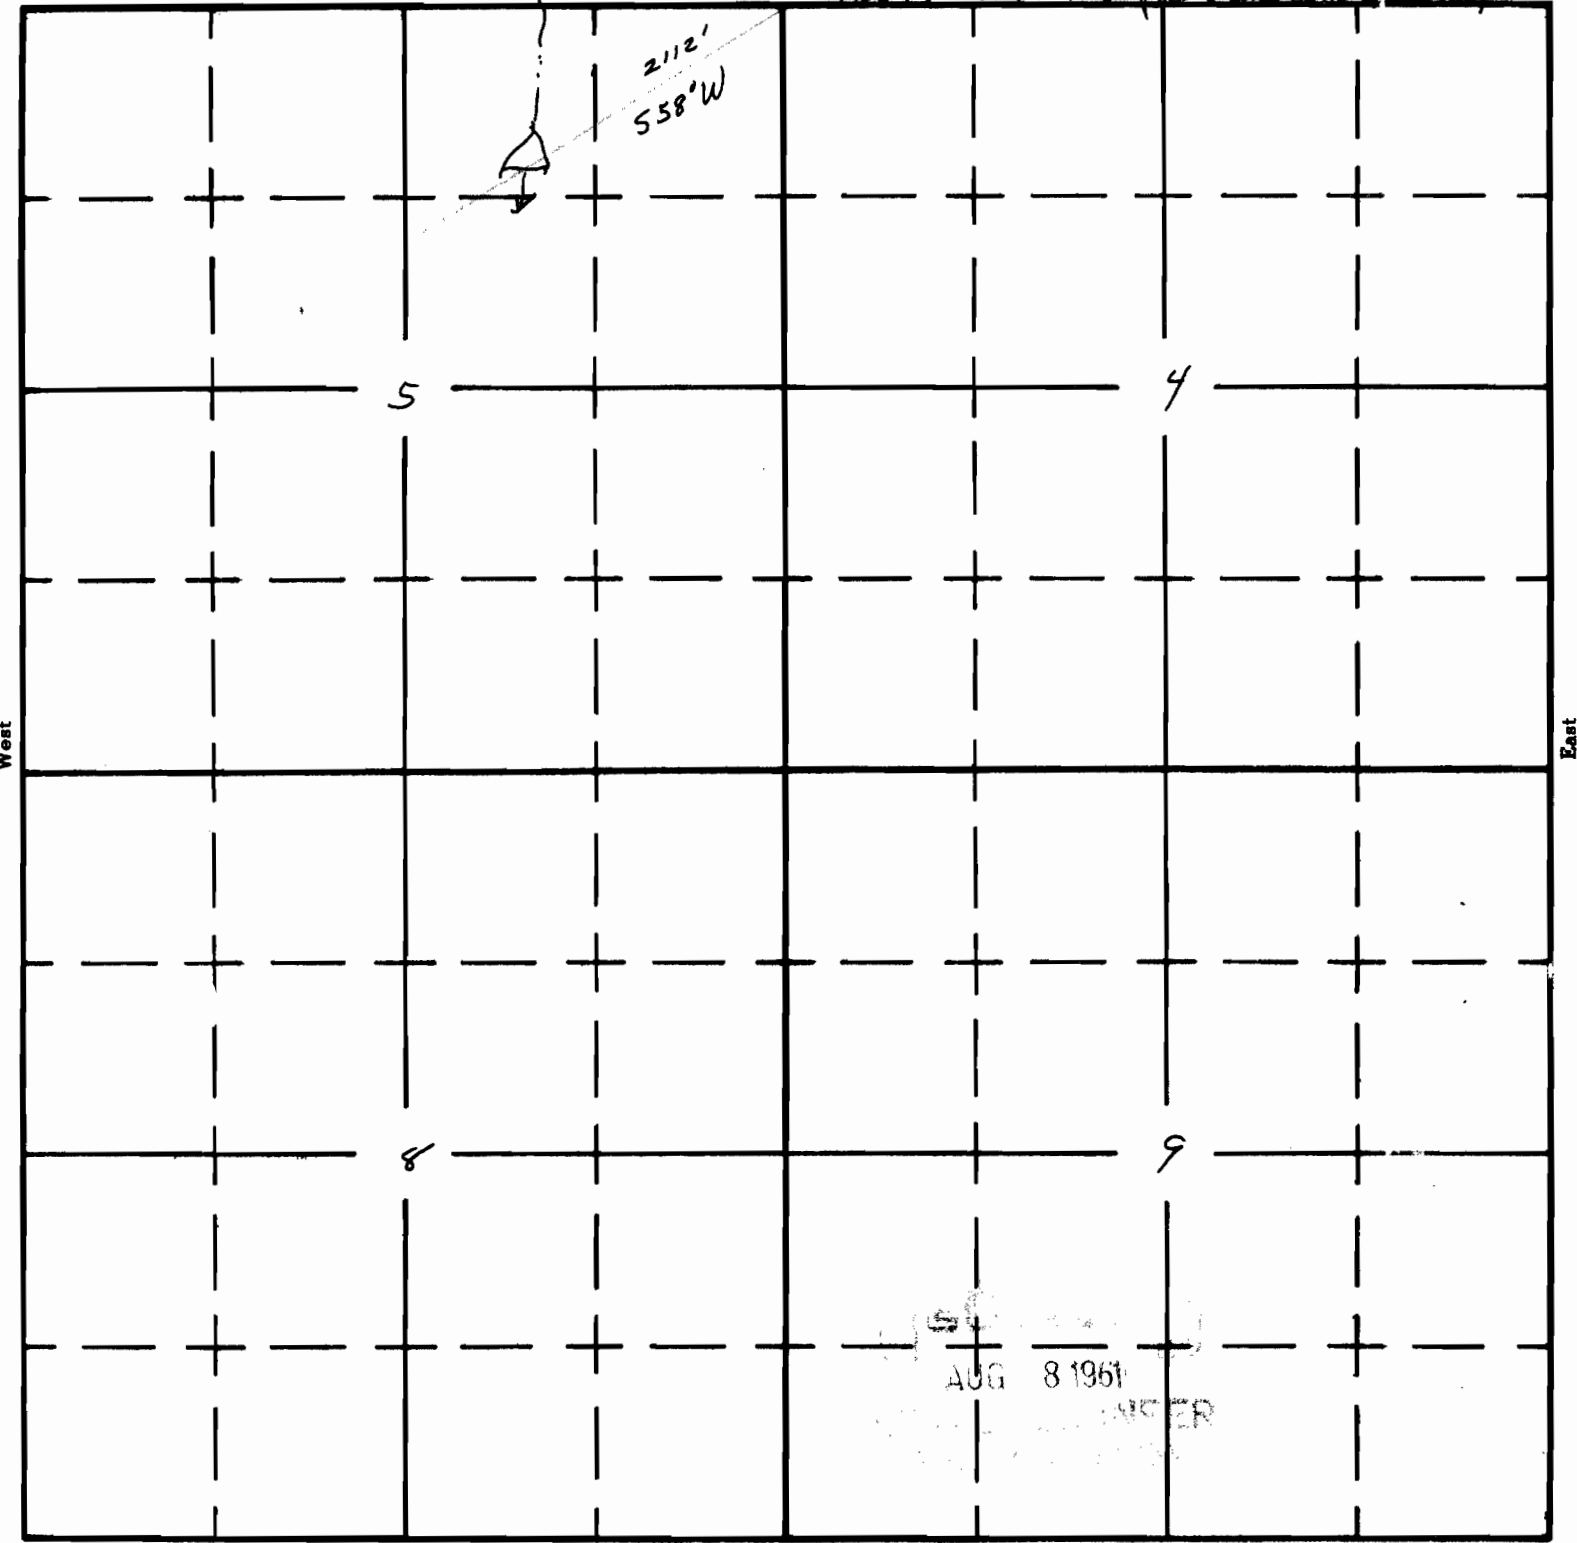

South

APPLICATION No. R-36558
PERMIT No. R 7237