

Form AI-187
March 1961


UNITED STATES
DEPARTMENT OF THE INTERIOR
BUREAU OF LAND MANAGEMENT

SECTION 1

Oregon State Water Filings

NE 1/4 SW 1/4 TOWNSHIP 24S, RANGE 18E, W. M.

Tied in with aerial photos & O.S.H.D. Quad Maps.

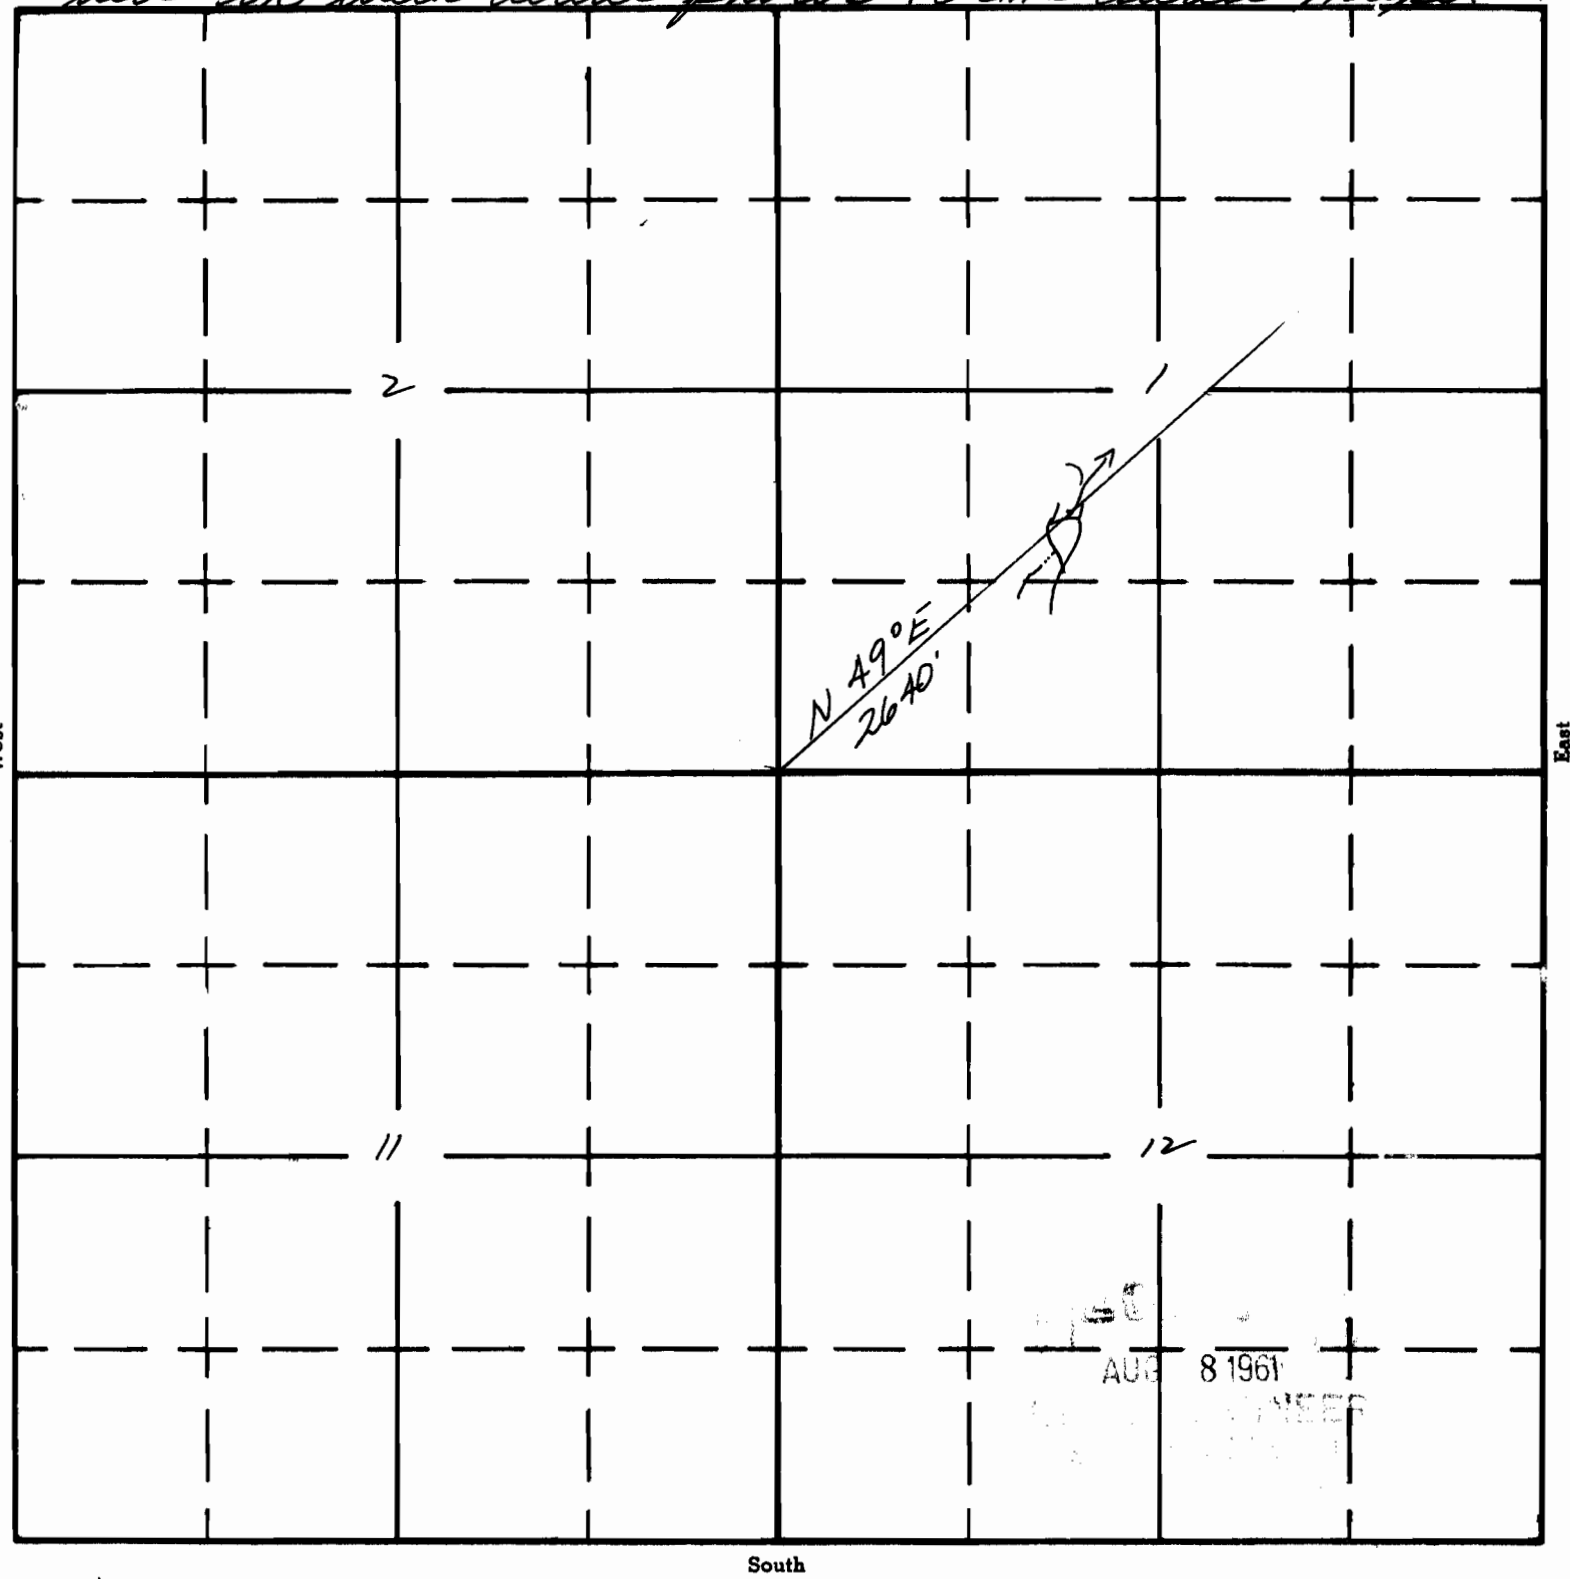

APPLICATION No. **R-36567**
PERMIT No. **R 7238**