

Form AI-187
March 1961


UNITED STATES
DEPARTMENT OF THE INTERIOR
BUREAU OF LAND MANAGEMENT

SECTION 7
NE 1/4 NW 1/4

Oregon State Water Filings

TOWNSHIP 28S, RANGE 13E, W. M.

North *Tied in with aerial Photo and OSAD Quad Map.*

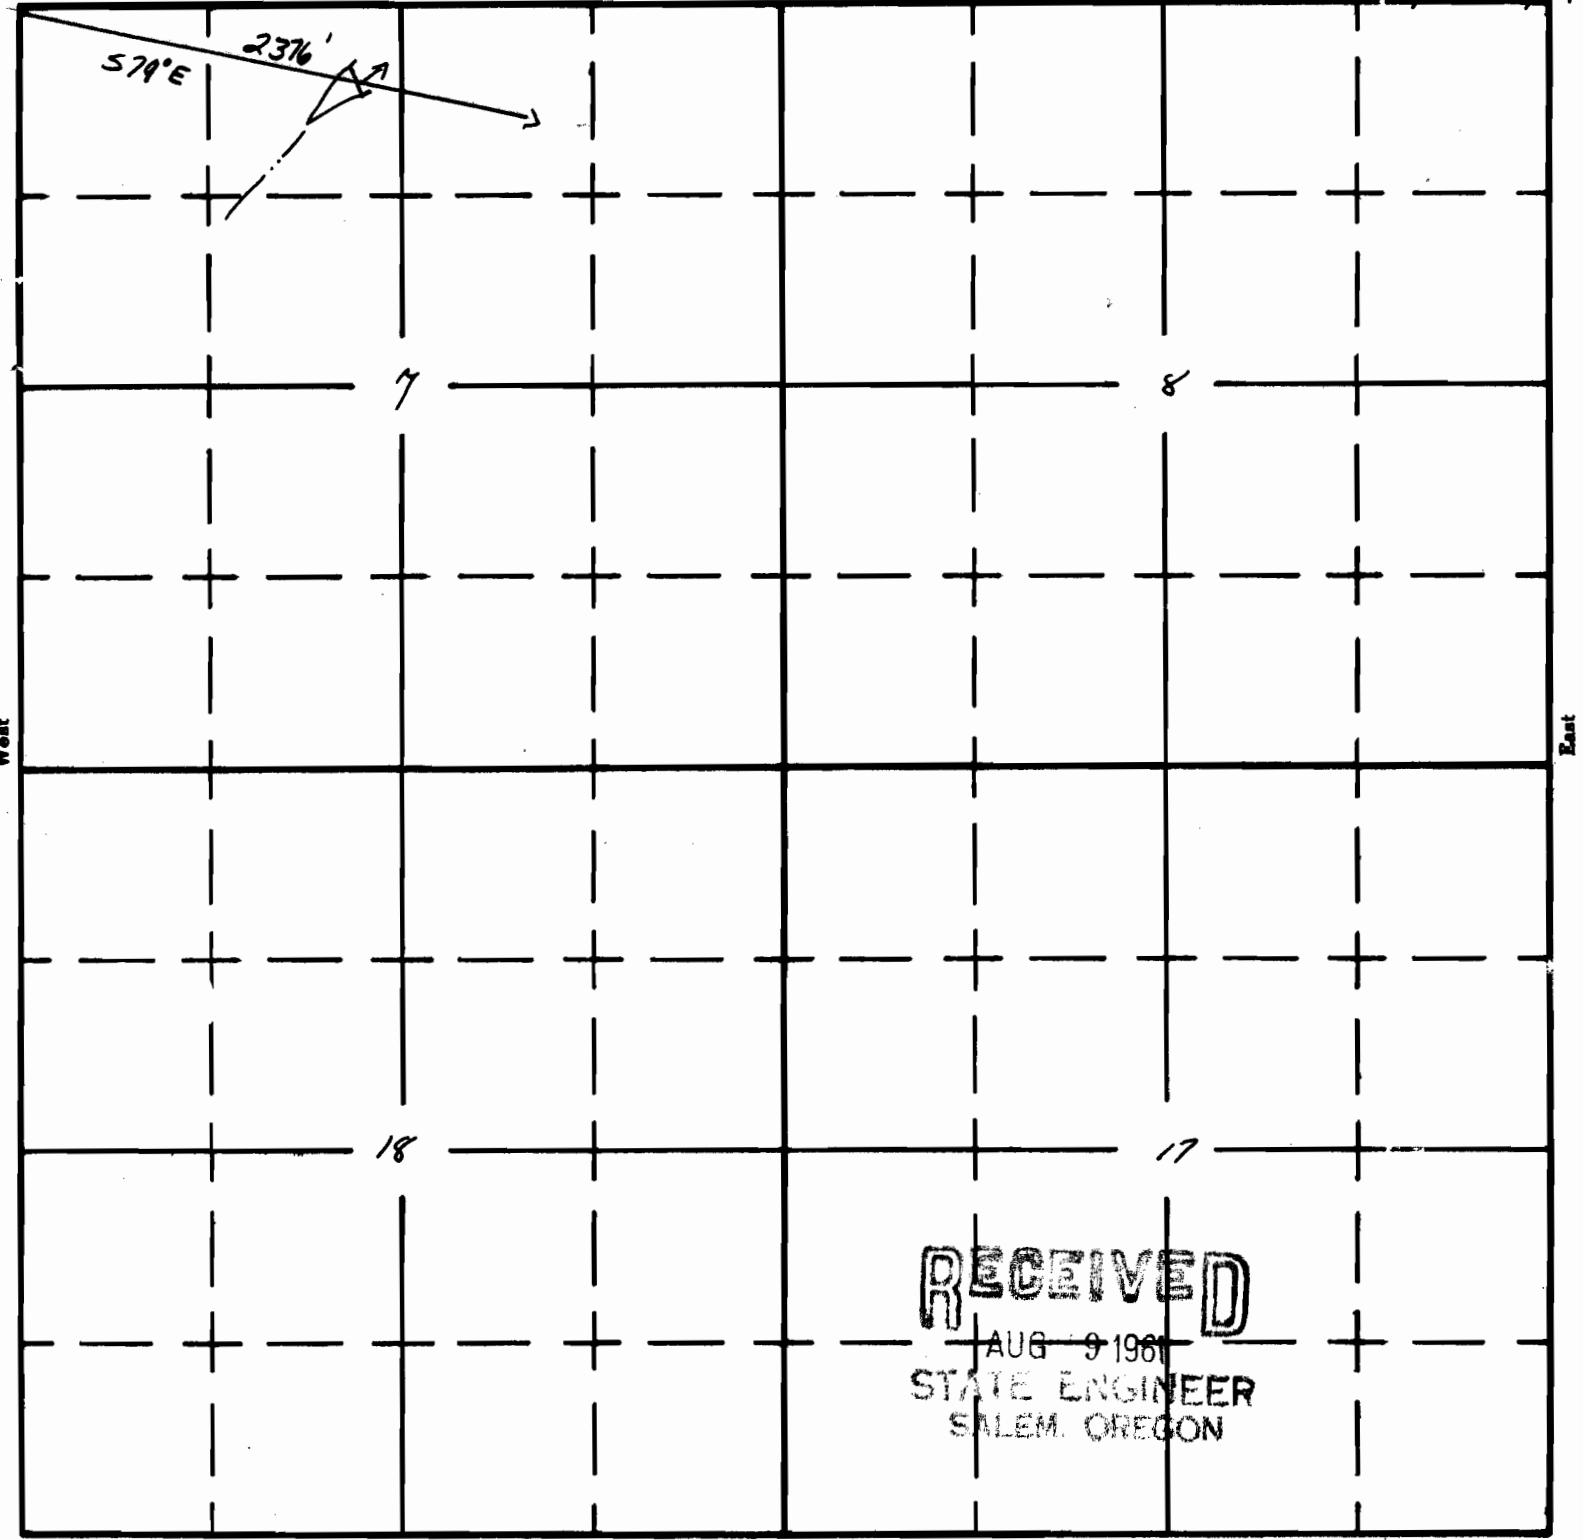

RECEIVED
AUG 9 1961
STATE ENGINEER
SALEM, OREGON

APPLICATION No. R-36960
PERMIT No. R 7366