

UNITED STATES
DEPARTMENT OF THE INTERIOR
BUREAU OF LAND MANAGEMENT

SECTION


23

Oregon State Water Filings

TOWNSHIP 28-S, RANGE 24-E, W. M.

RECEIVED
0013 1961
STATE OF OREGON
BUREAU OF LAND MANAGEMENT

North

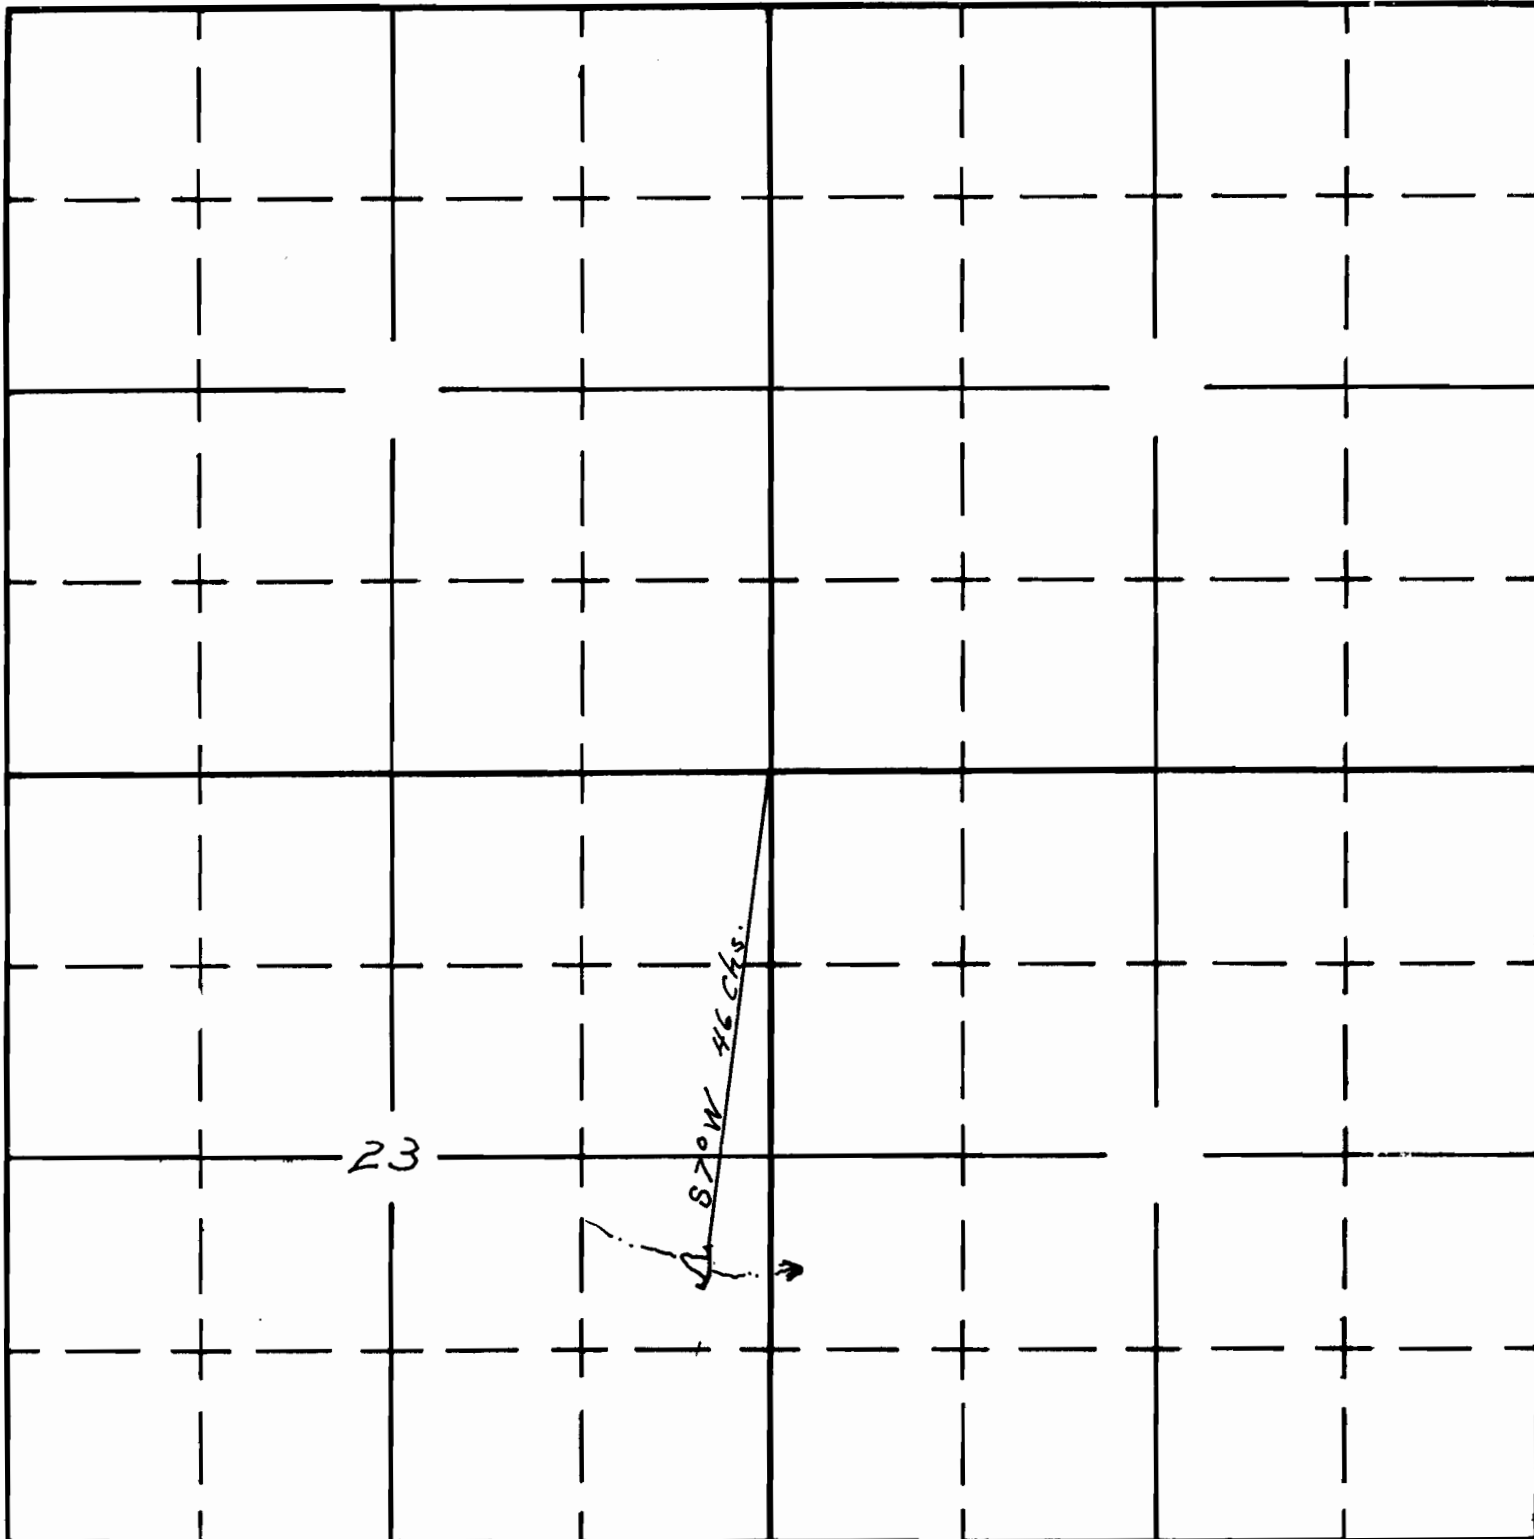

South

APPLICATION No. A-38145
PERMIT No. B-3182