

R9510  
75399

Form OR-010-7300-2  
4/83

UNITED STATES  
DEPARTMENT OF THE INTERIOR  
BUREAU OF LAND MANAGEMENT

Section 22  
SE 1/4 NE 1/4


Township 29 S  
Range 24 E

Appl. No. R67652  
Permit No. R 9510

4 INCHES = 1 MILE

Will. Mer.

REHAB # 4231

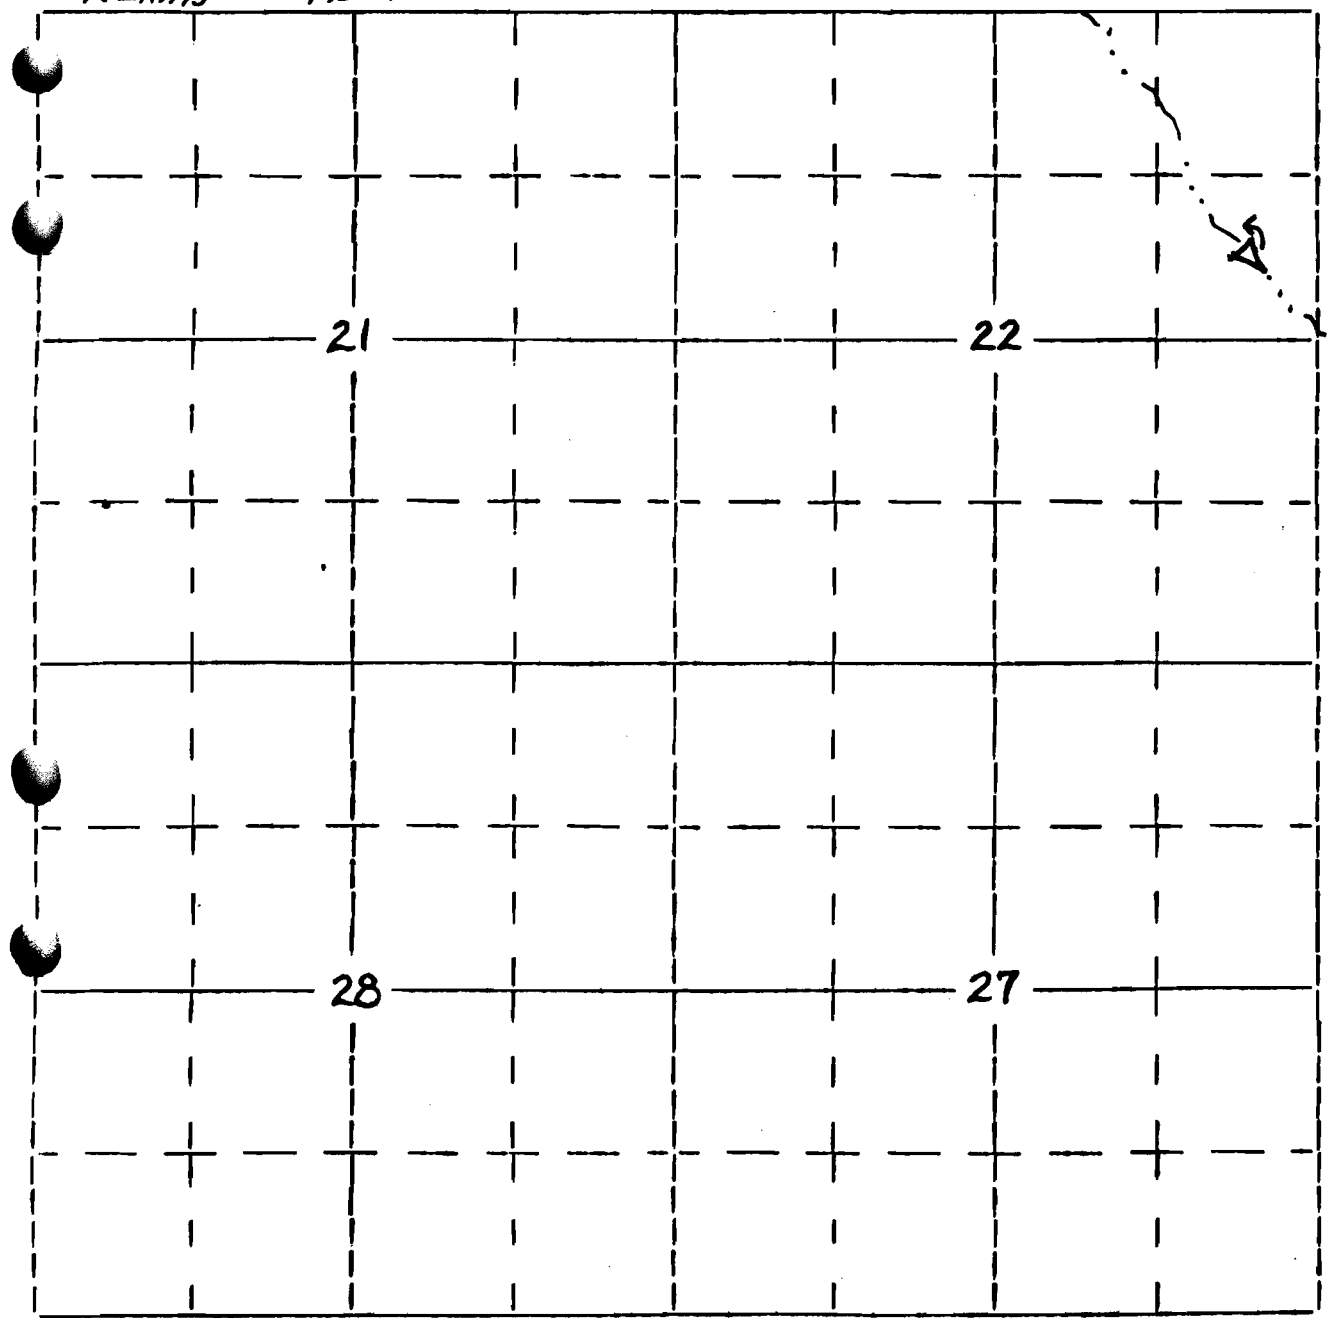

REHAB RESERVOIR # OR-010-R-4231

LOCATED 1,700 FEET SOUTH AND 400 FEET  
WEST OF THE NORTHEAST CORNER OF SEC. 23.