

75400

4/83

BUREAU OF LAND MANAGEMENT

Section

29


SW SW

Range 18 east

Appl. No. **R67658**

Permit No. **R 9515**

DEAD #4126

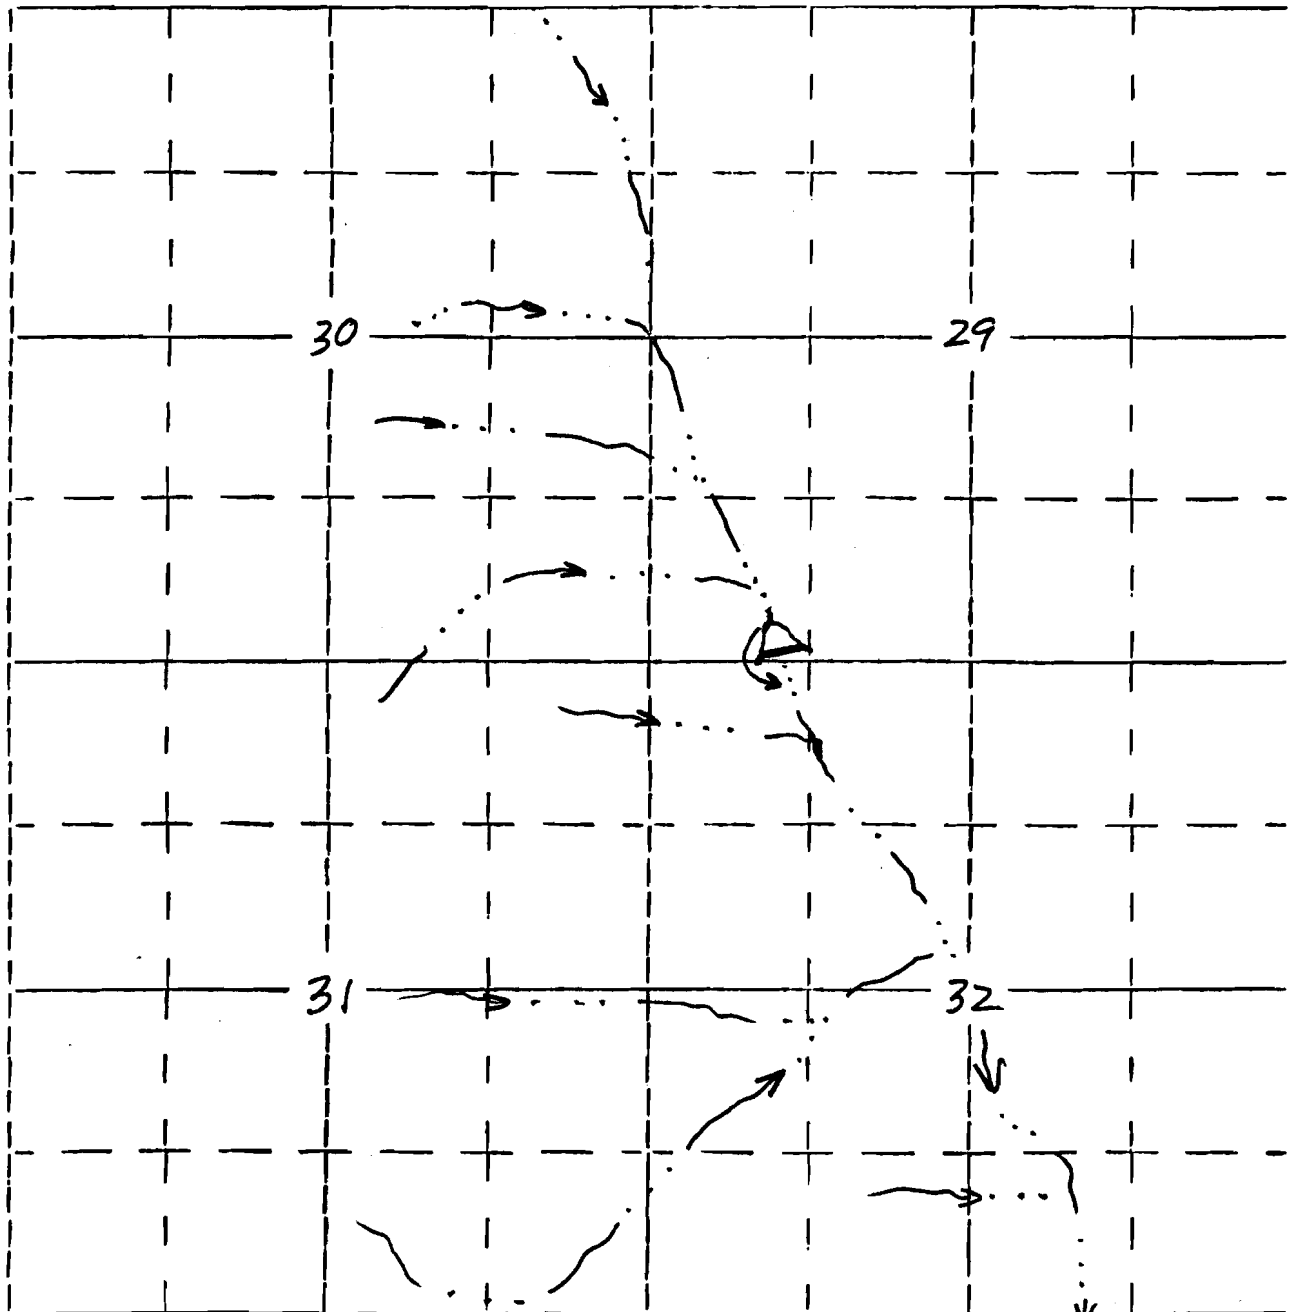

55' N., 1185' E. of SW Corner, section 29

14-00000