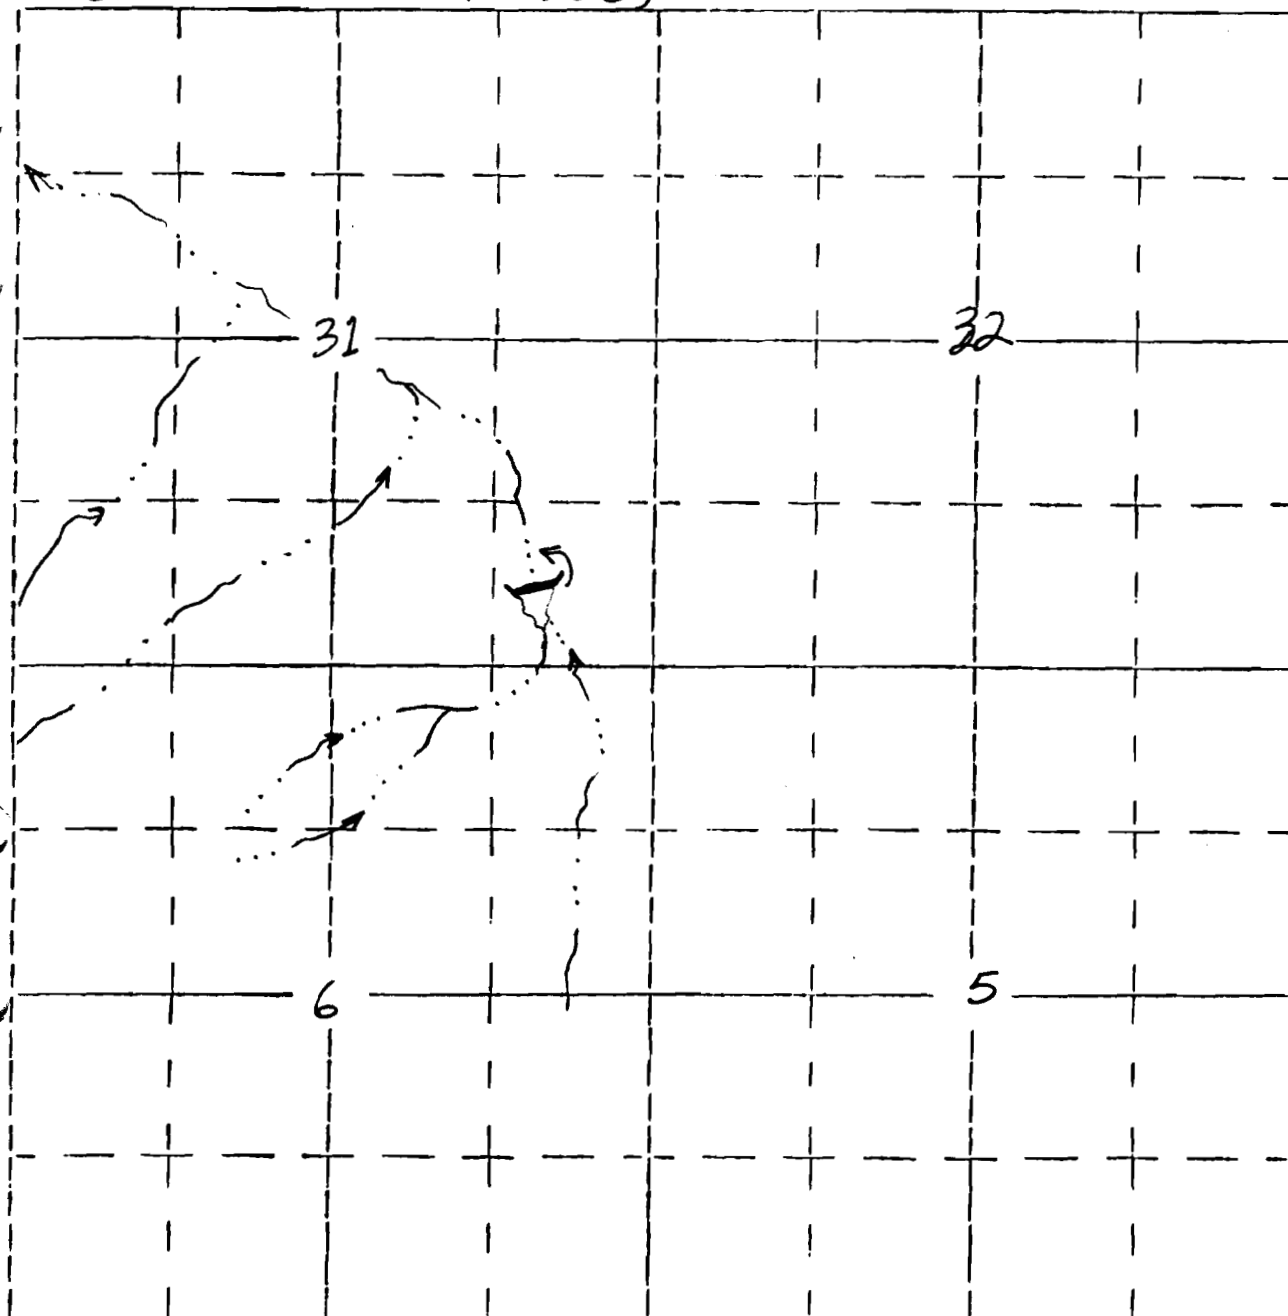


Form OR-010-7300-2
4/83UNITED STATES
DEPARTMENT OF THE INTERIOR
BUREAU OF LAND MANAGEMENT

Section

31SESETownship 28 south
Range 17 eastAppl. No. R67660Permit No. R 9517New Reservoir (#1220)

T 28 S

T 29 S

635' N, 950' W. of SE Corner, section 31

B22017