

Form OR-010-7300-2
4/83

UNITED STATES
DEPARTMENT OF THE INTERIOR
BUREAU OF LAND MANAGEMENT

Section

18


SW NW

Township 32 S
Range 22 E

Appl. No. **R67665**

Permit No. **R 9521**

CLUB #1514

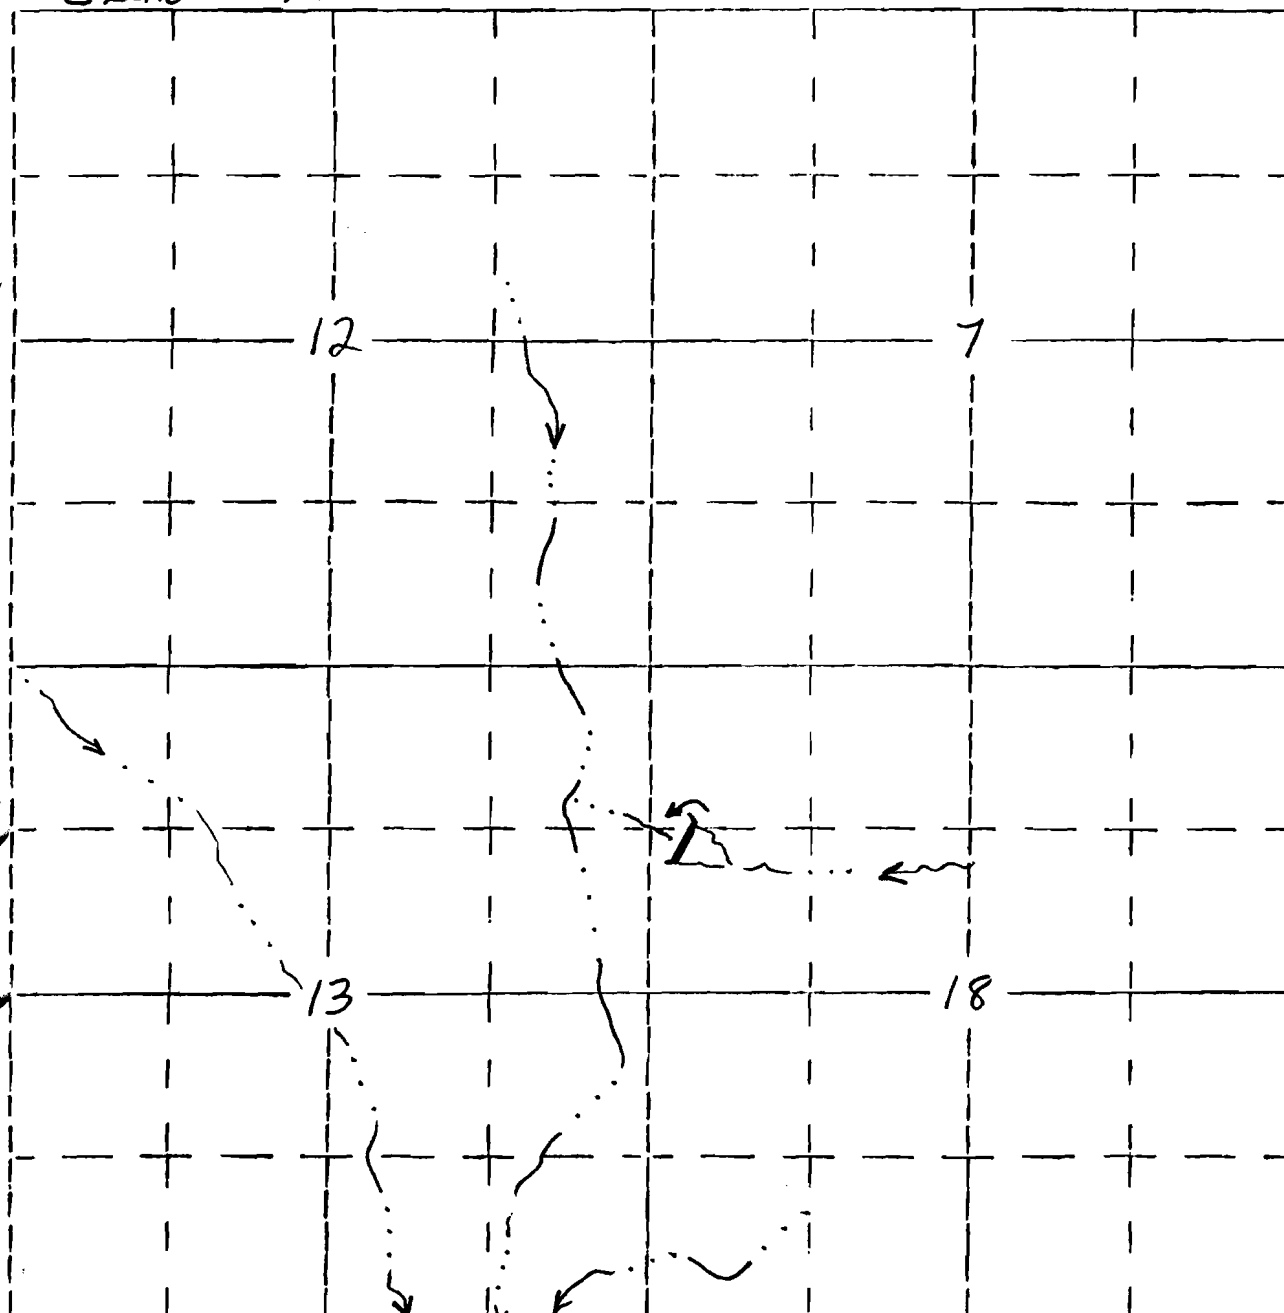

14.15' S., 265' E of NW Corner of section 18

R 21 E

R 22 E