

R9528  
75404

Form OR-010-7300-2  
4/83


UNITED STATES  
DEPARTMENT OF THE INTERIOR  
BUREAU OF LAND MANAGEMENT

Section 28  
NWSE

Township 27 south  
Range 13 east

Appl. No. R67672  
Permit No. R 9528

NORTH WARD # 5297

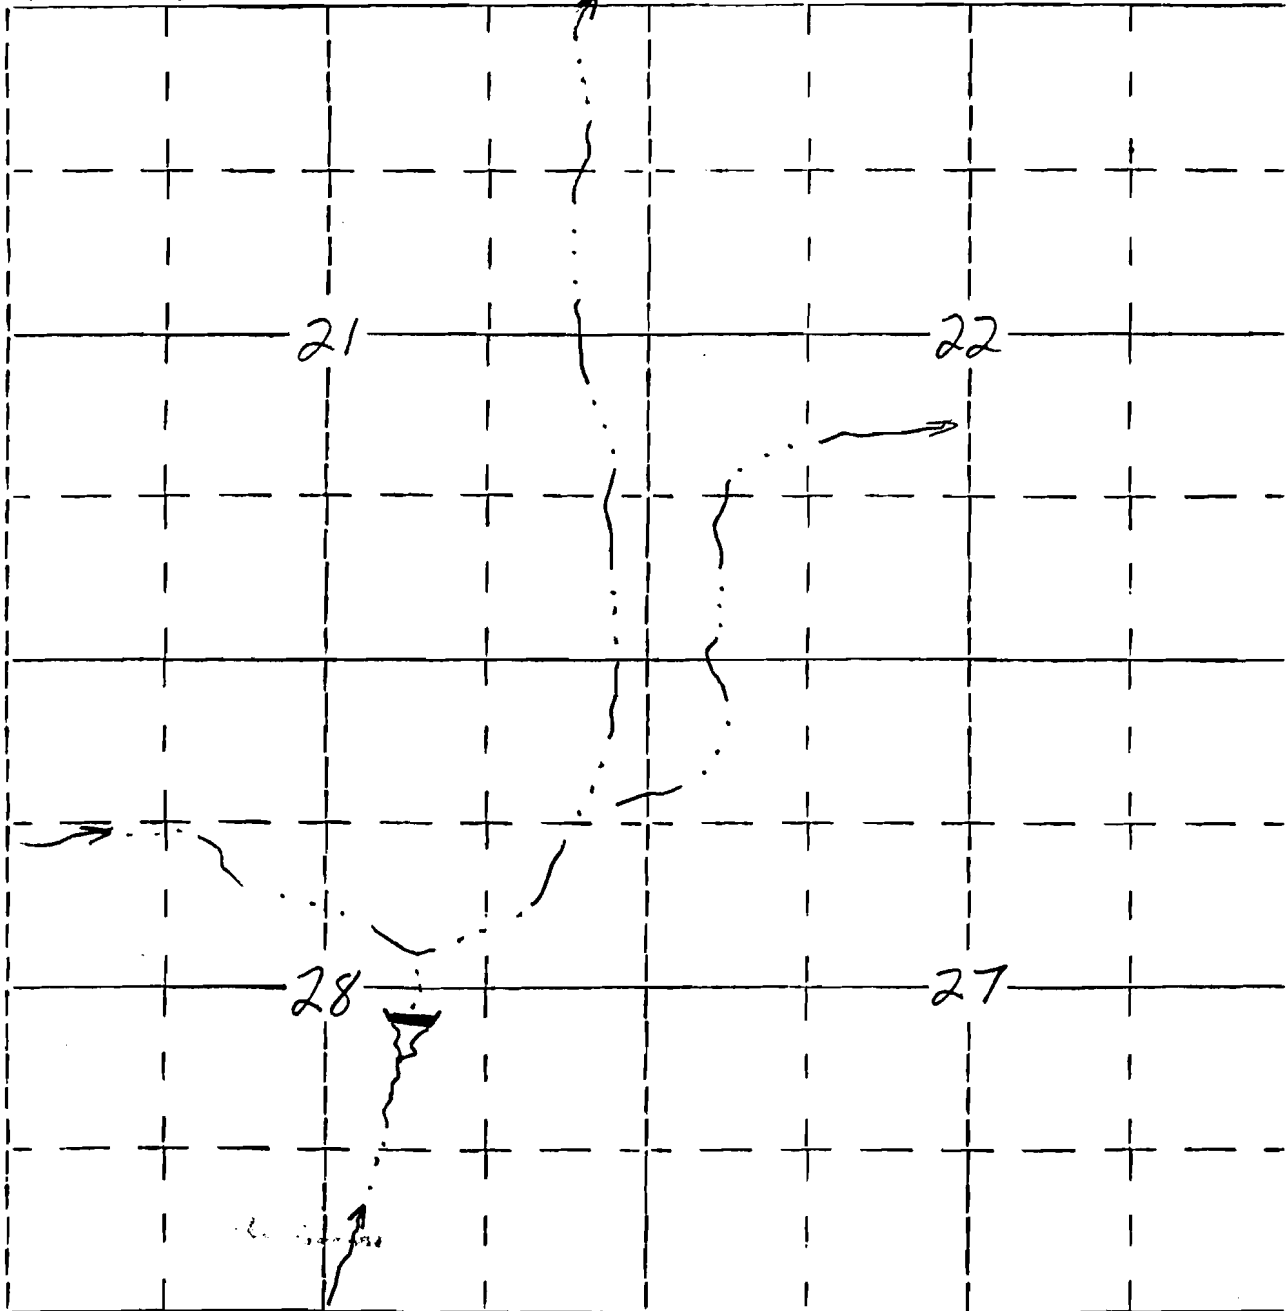

2430' N., 1900' W. of SE corner, section 28