

R9596
75405

Form OR-010-7300-2
4/83

UNITED STATES
DEPARTMENT OF THE INTERIOR
BUREAU OF LAND MANAGEMENT

Section

18

NWSE


Township 29 south
Range 16 east

Appl. No. R-67788

Permit No. R 9596

Gary & Rich W. H. # 1 (#5308)

Silver
Lake

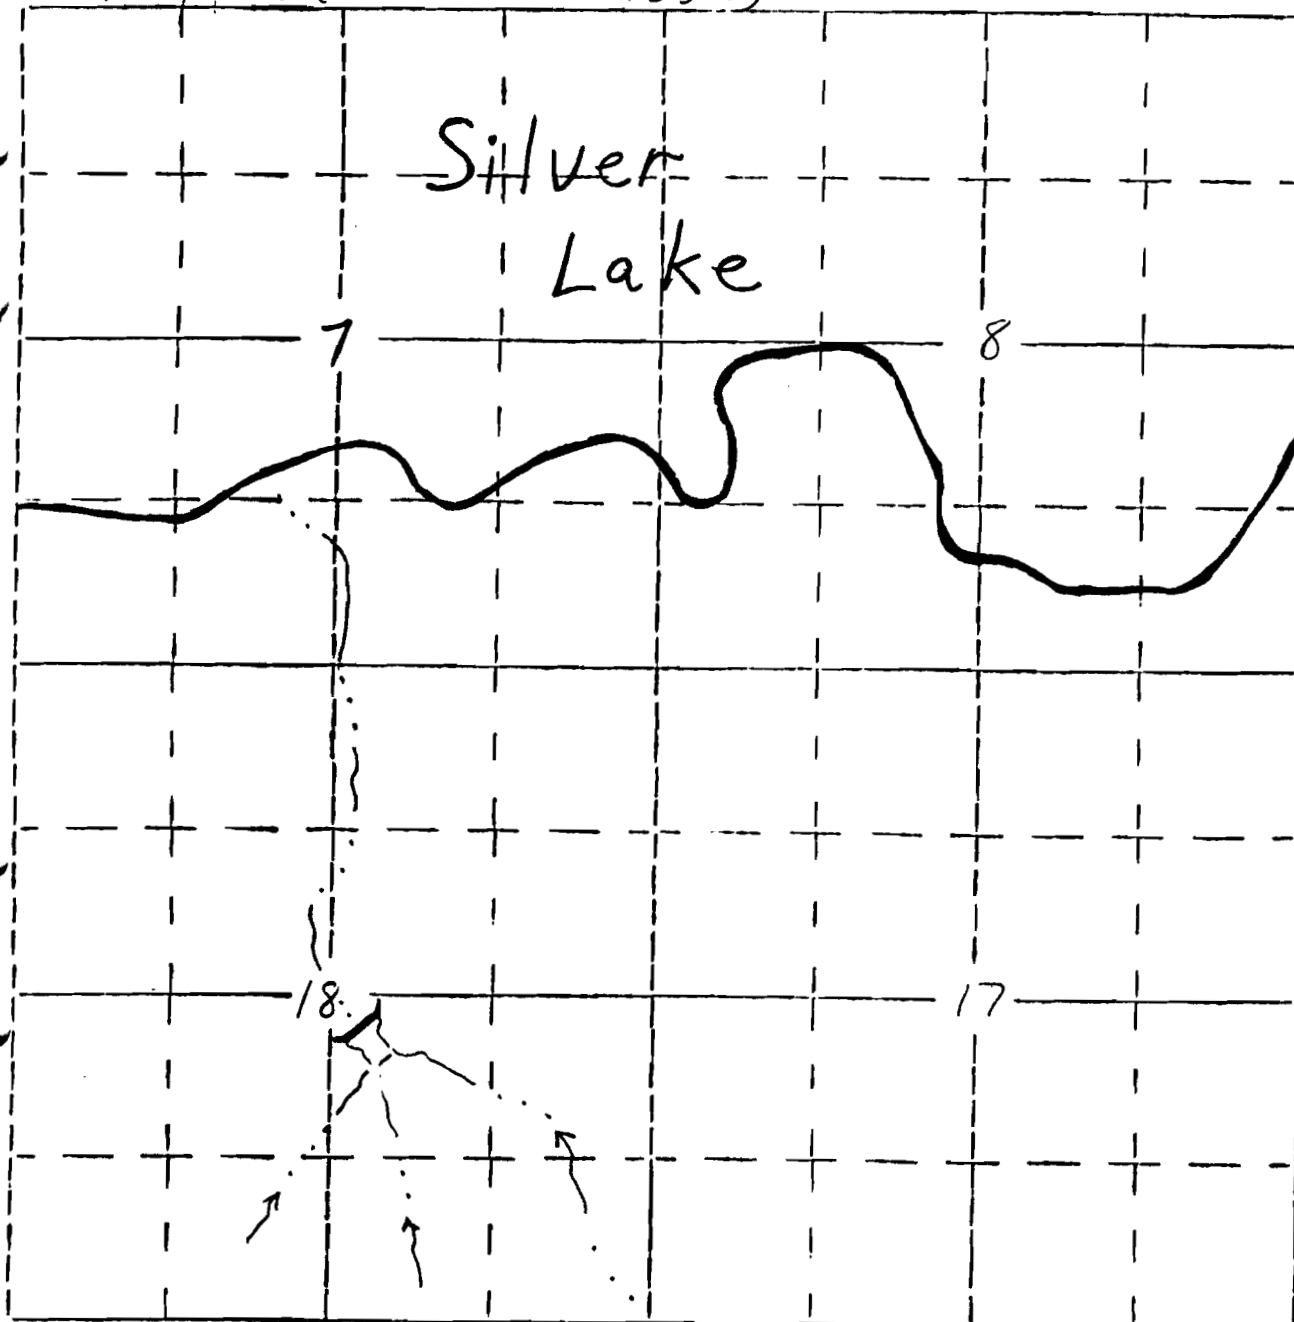

2590' N., 2500' W. of SE Corner, section 18

RECEIVED

OCT 14 1983
WATER RESOURCES DEPT.
SALEM, OREGON