

R9600  
75406

Form OR-010-7300-2  
4/83

UNITED STATES  
DEPARTMENT OF THE INTERIOR  
BUREAU OF LAND MANAGEMENT

Section

12


NW SE

Township 23 south  
Range 17 east

Appl. No. R-67792

Permit No. R 9600

Can Can Reservoir (#1447)

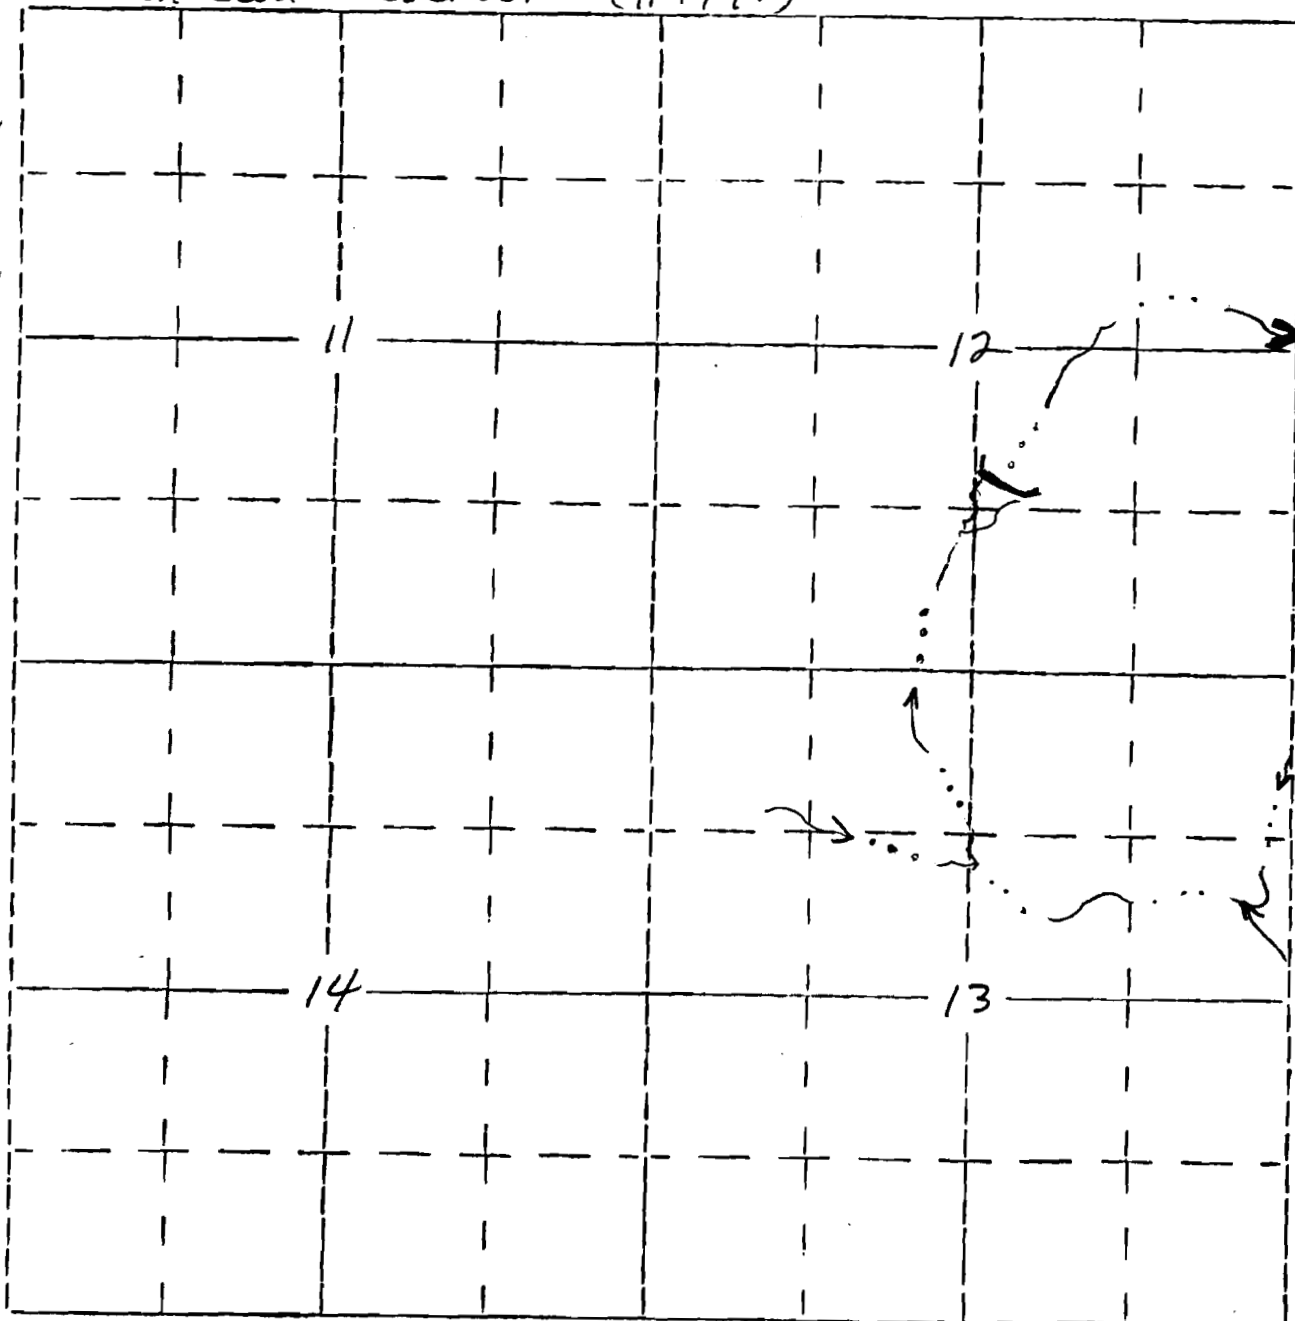

1410' N., 2520' W. of SW Corner, sec. 12

**RECEIVED**  
OCT 16 1983  
WATER RESOURCES DEPT.  
SALEM, OREGON