

R9524
75407

Form OR-010-7300-2
4/83


UNITED STATES
DEPARTMENT OF THE INTERIOR
BUREAU OF LAND MANAGEMENT

Section 23
NESW

Township 28 South
Range 17 East

Appl. No. R67668
Permit No. R 9524

Look Reservoir (#4130)

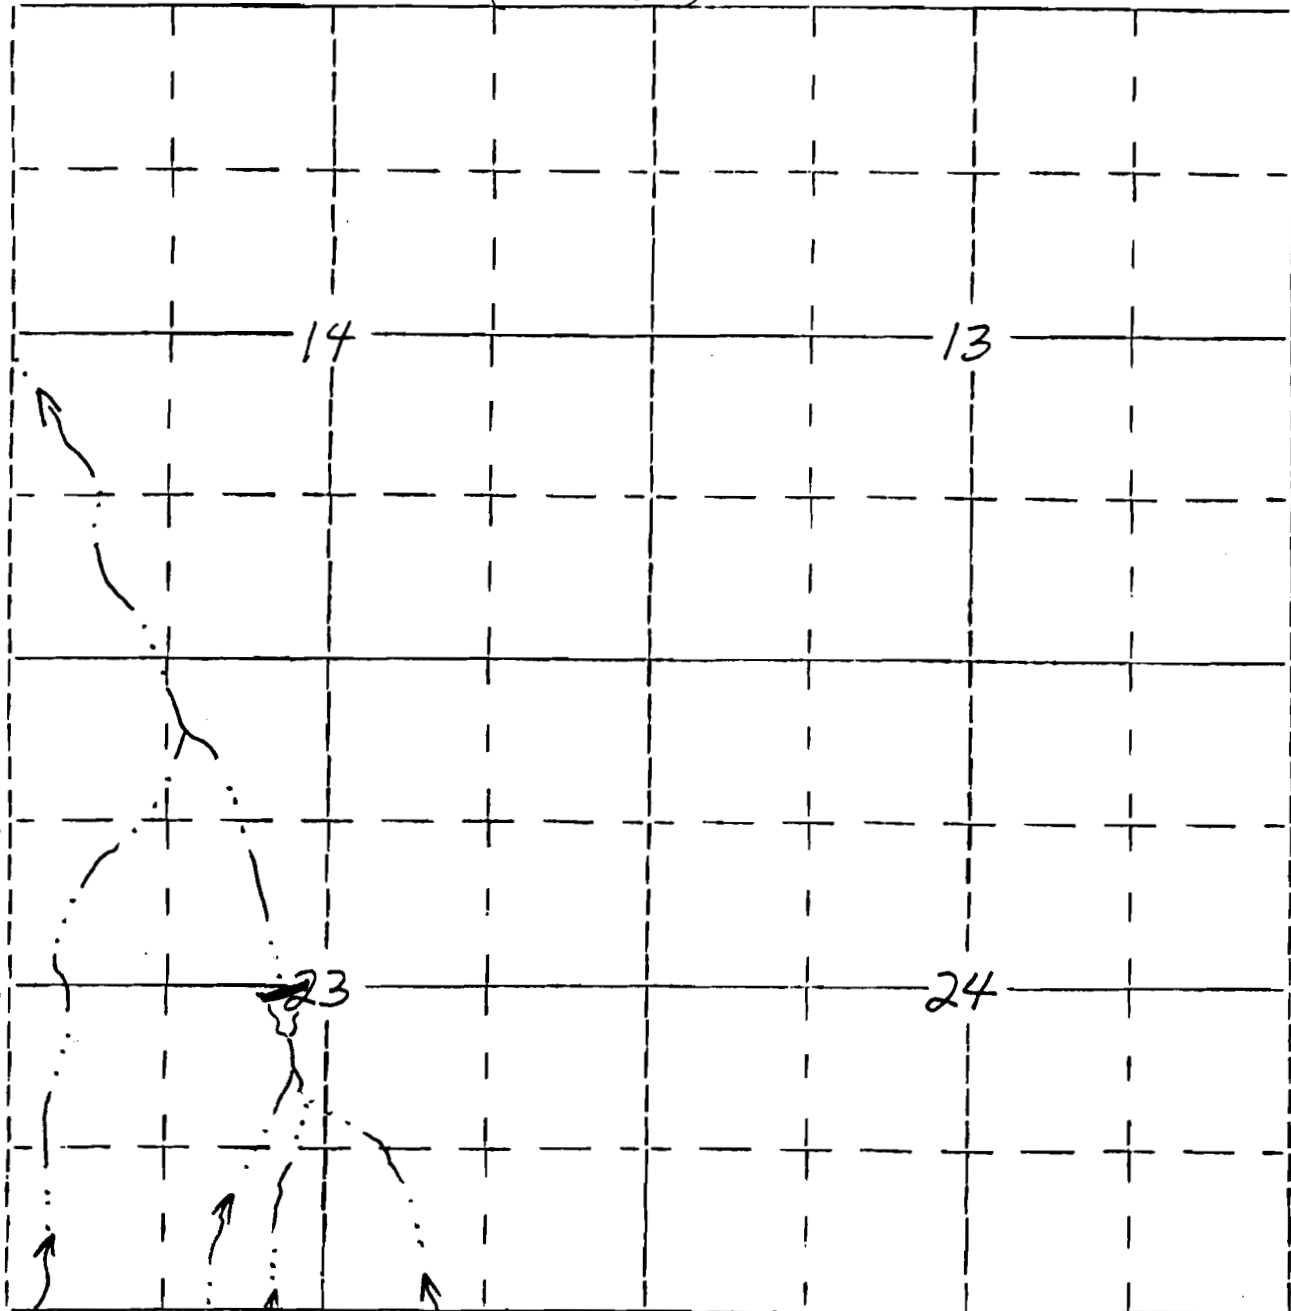

2535' N., 2270' E. of SW corner, section 23