


T.4N., R.7W., W.M.

SEC. 4

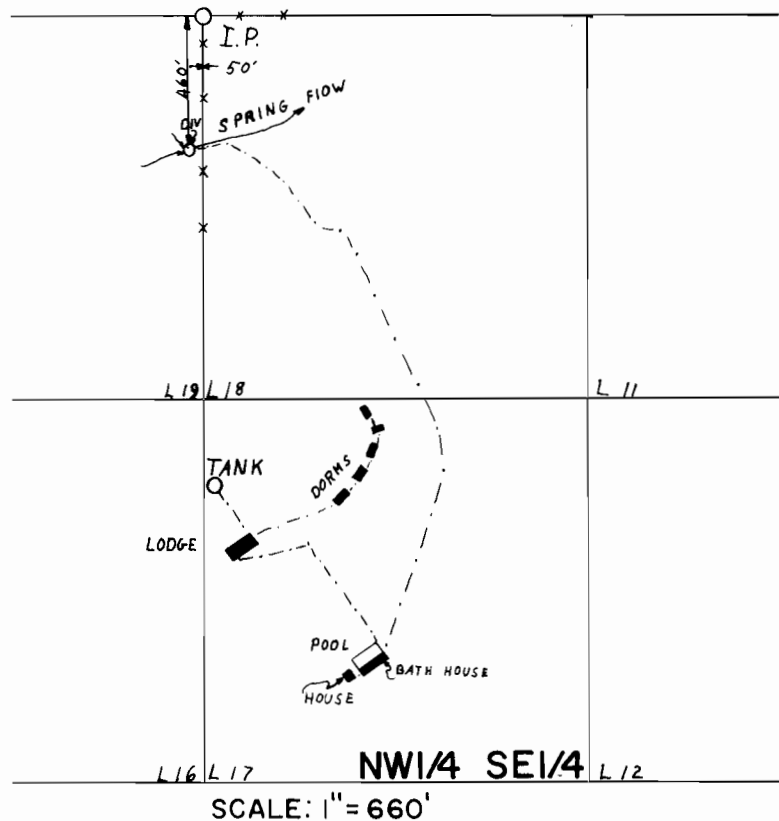

FINAL PROOF SURVEY
UNDER

Application No. 49095 Permit No. 35937
IN NAME OF

OSWALD C. SVEHAUG

Surveyed SEPT. 15, 1976, by G.R. KING