

RECEIVED


AUG - 1 1997

WATER RESOURCES DEPT.
SALEM, OREGON

SECTION 13

SW $\frac{1}{4}$ SE $\frac{1}{4}$

TOWNSHIP 22S RANGE 42E W.M.

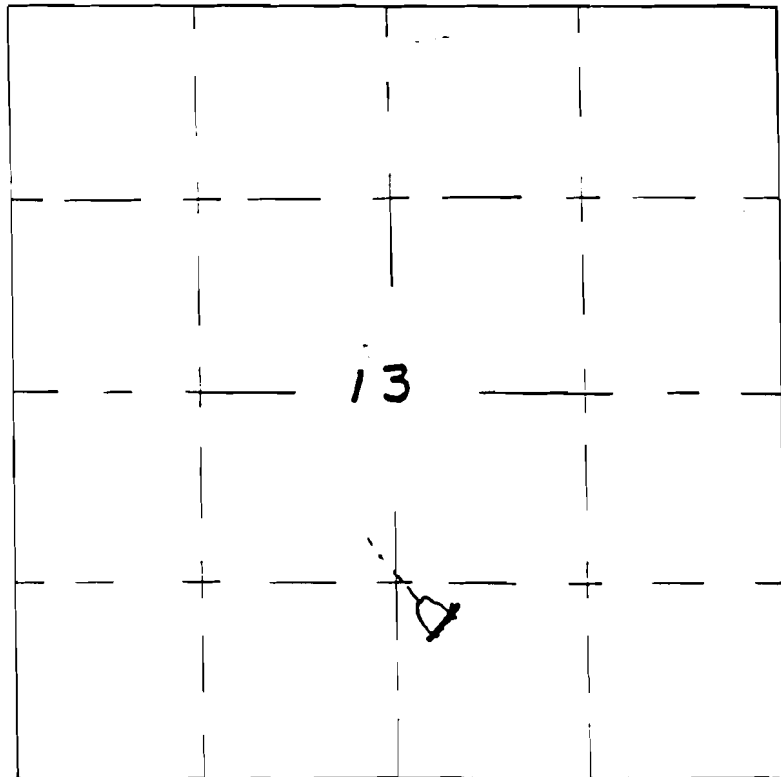

Spotted Horse
NR 59054

Permit No. R 8700