


SECTION 19

NW 1/4 SE 1/4

TOWNSHIP 37S RANGE 42E W.M.

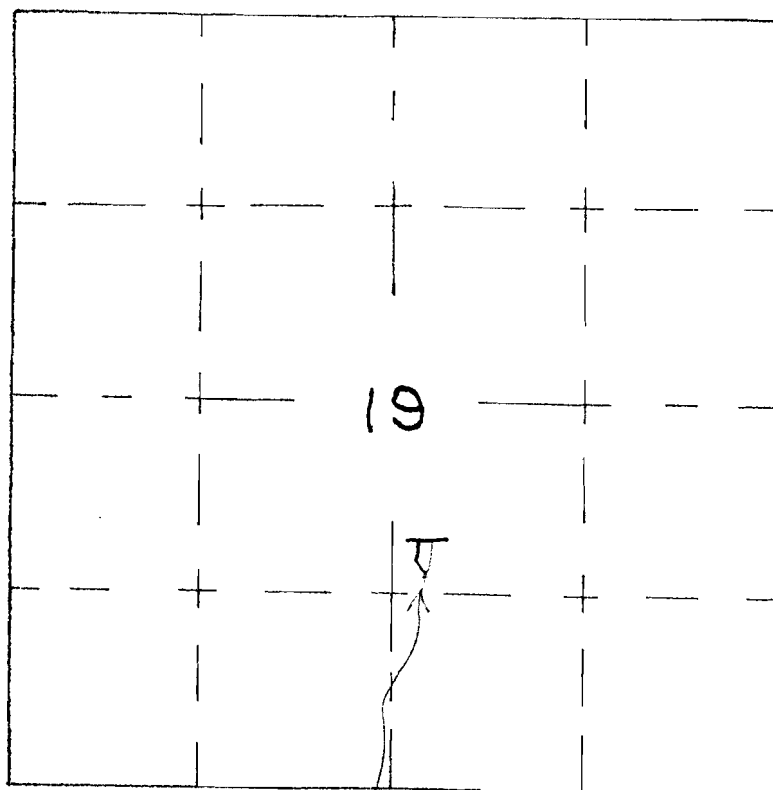

Application No. **R59148**

Permit No. **R 8781**

U. S. DEPARTMENT OF THE INTERIOR
BUREAU OF LAND MANAGEMENT

BLUE MTN. # 1

DESIGNED _____

RECOMM. _____

DRAWN _____

RECOMM. _____

CHIEF, DIV. OF ENG.

CHECKED _____

APPROVED _____

SCALE _____

DATE _____

SHEET _____ OF _____

DRAWING NO. _____

RECEIVED


AUG - 1 1997

WATER RESOURCES DEPT.
SALEM, OREGON

SECTION 19

NW 1/4 SE 1/4

TOWNSHIP 37S RANGE 42E W.M.

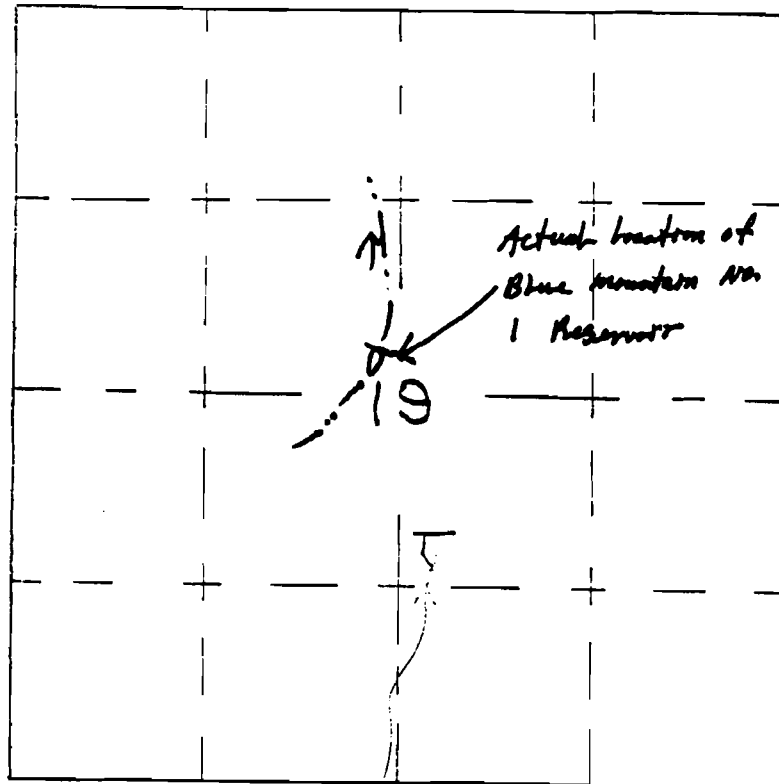

Application No. B59148

Permit No. R 8731

U. S. DEPARTMENT OF THE INTERIOR
BUREAU OF LAND MANAGEMENT

BLUE MTN. # 1

DESIGNED _____

RECOMM. _____

DRAWN _____

RECOMM. _____

CHIEF, DIV. OF ENG.

CHECKED _____

APPROVED _____

SCALE _____

DATE _____

SHEET _____ OF _____

DRAWING NO. _____