


RECEIVED

1978

W.M.

T. 21 S. R. 40 E. W.M.

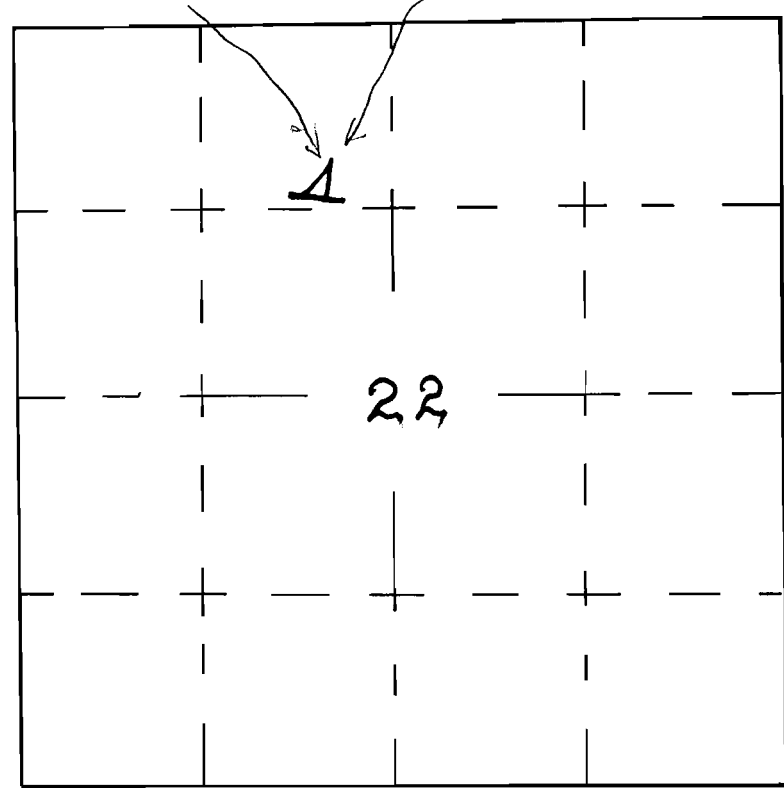


Application No. R59167

Permit No. R 8797

U. S. DEPARTMENT OF THE INTERIOR BUREAU OF LAND MANAGEMENT	
DUKE	
DESIGNED _____	RECOMM. _____
DRAWN _____	RECOMM. _____
CHECKED _____	APPROVED _____
SCALE _____	
DATE _____	SHEET _____ OF _____
DRAWING NO. _____	

T. 21 S. R. 40 E. W.M.

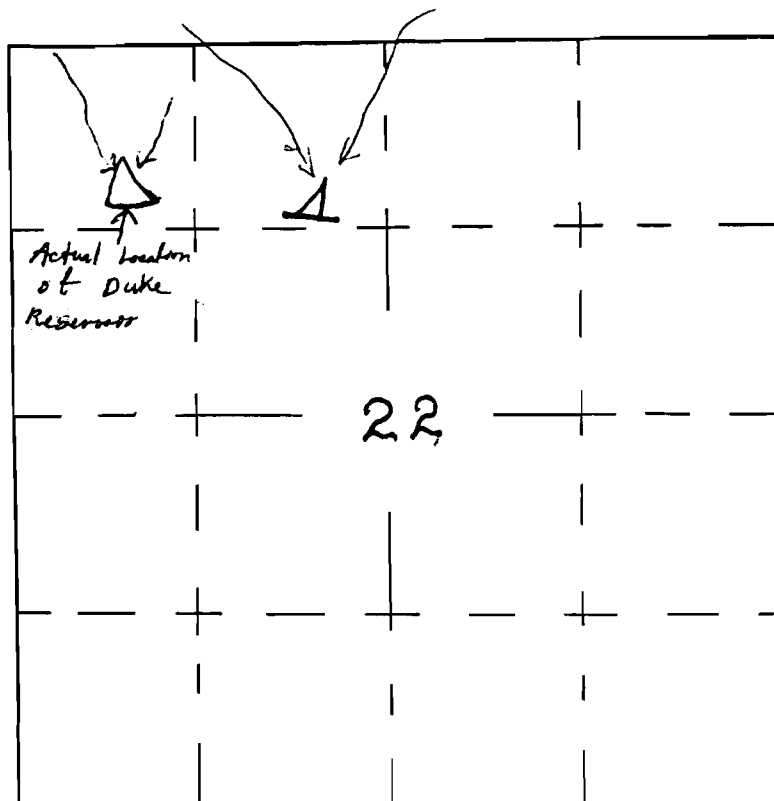

Application No. R59167

Permit No. R 8797

U. S. DEPARTMENT OF THE INTERIOR
BUREAU OF LAND MANAGEMENT

DUKE

DESIGNED _____	RECOMM. _____
DRAWN _____	RECOMM. _____
CHECKED _____	APPROVED _____
SCALE _____	
DATE _____	SHEET _____ OF _____
DRAWING NO. _____	