

~~MAP 3~~

P. 17621
Pr. Mar 19,
1947


MAP 2

RECEIVED

T. 36 S., R. 1 W., W. M.

APR 15 1996

WATER RESOURCES DEPT.
SALEM, OREGON

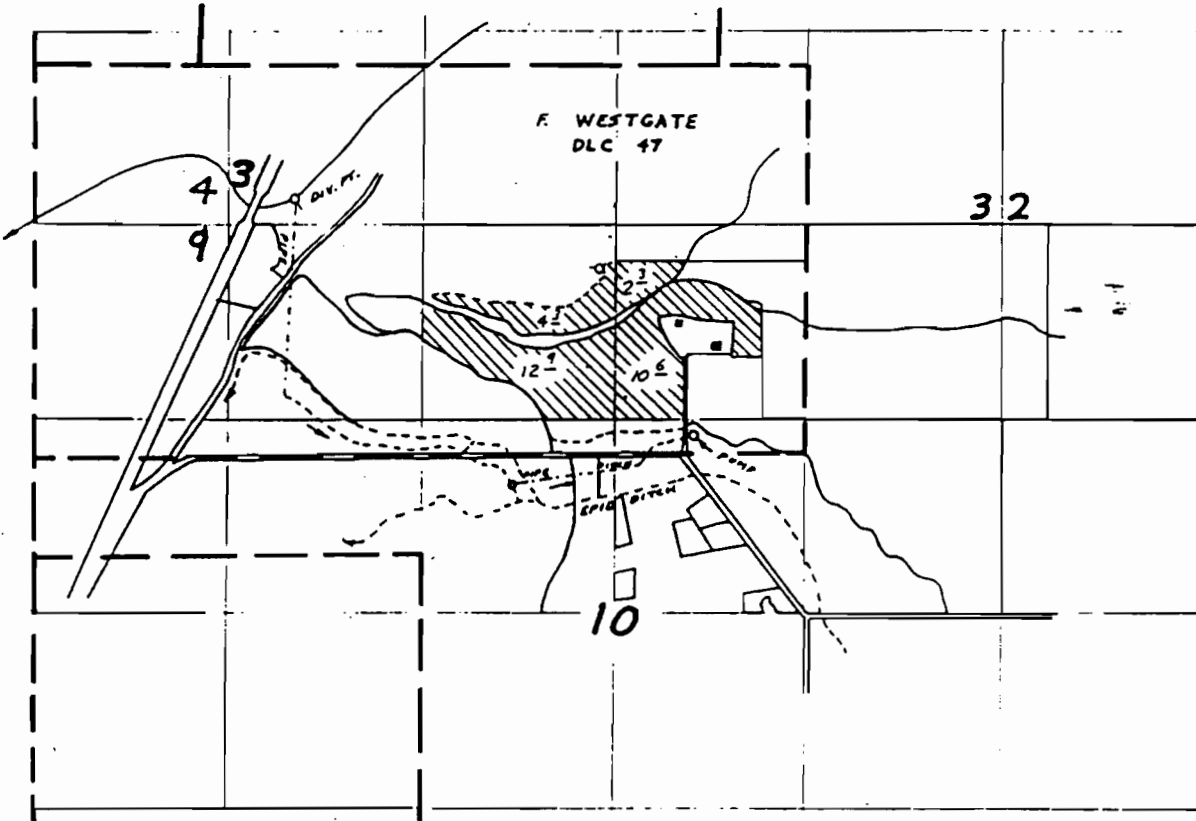

FINAL PROOF SURVEY
UNDER

CERT. No. 20730

Application No. 22350 Permit No. 17621

IN NAME OF

ALA VISTA ORCHARDS

Surveyed DEC 12 1980, by B.P. SUND

scale: 4" = 1 mile

BAX-3AA-6
EPID PHOTO 66