


G 10161

61760
75433

T. 27 S., R. 19 E., W.M.

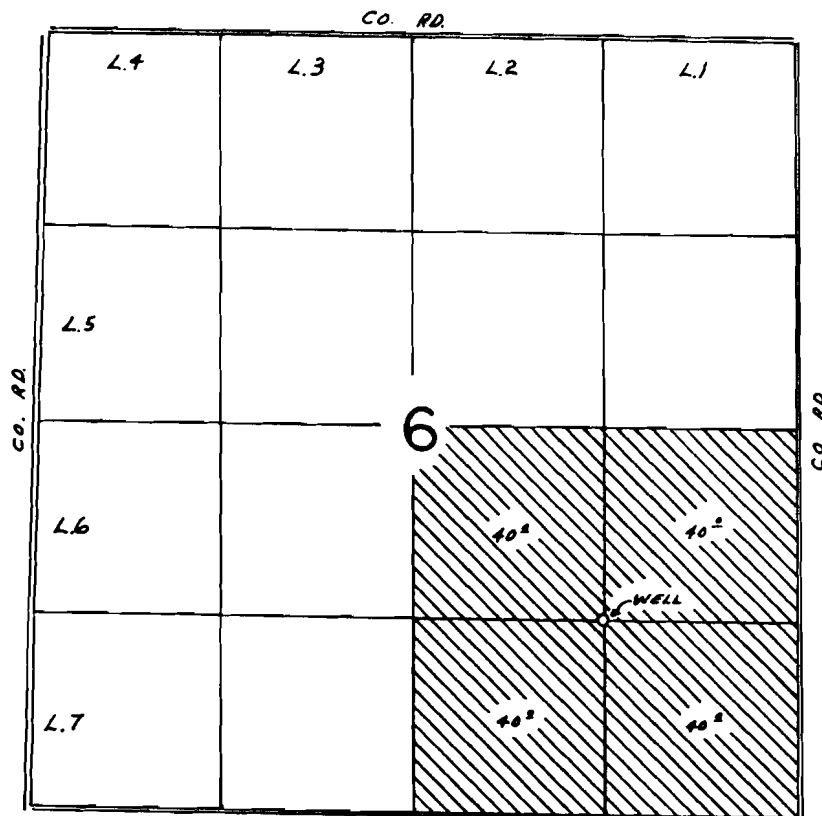

WELL LOC.: 1330' N. & 1320' W. FROM S.E. COR. SEC. 6

SCALE: 1"=1320'

FINAL PROOF SURVEY
UNDERApplication No. G-11030 Permit No. G-10161
IN NAME OF

FLOWERREE FARMS INC.

Surveyed AUG. 29 1988, by B. BISHOP