


T. 29 S., R. 4 W., W.M.

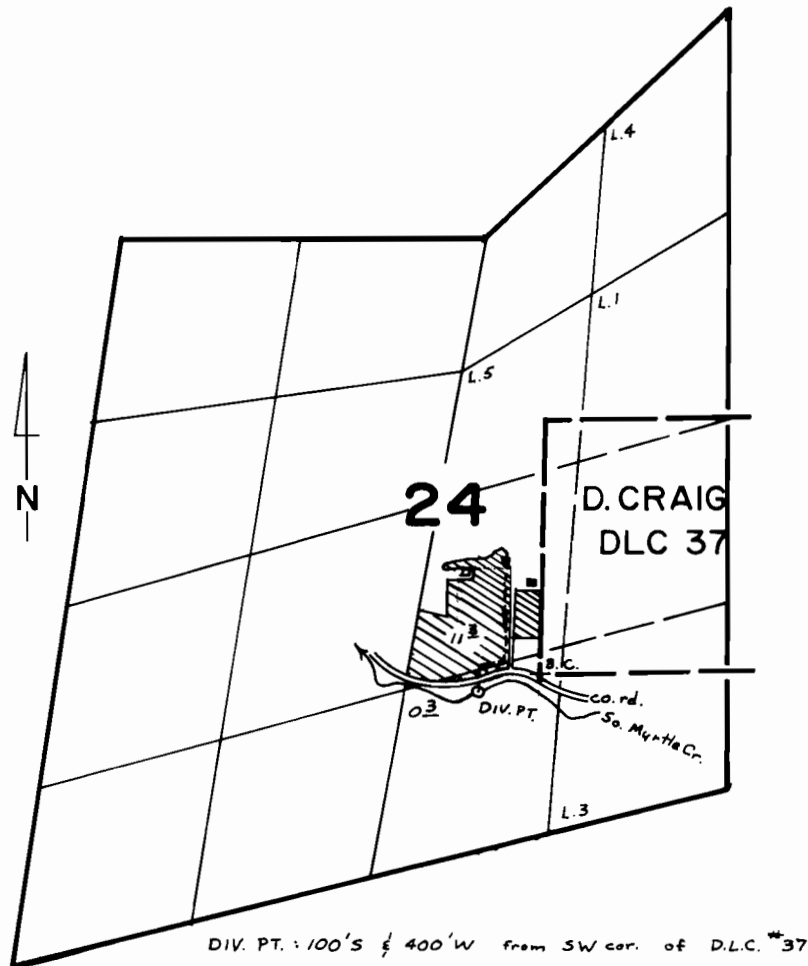

SCALE 4" = 1 mile

FINAL PROOF SURVEY
UNDER

Application No. ~~51668~~. Permit No. ~~38958~~....
IN NAME OF

.....RICHARD A. GRAF.....

Surveyed April 4, 1979, by S. Donaldson....
MAY 8, 1986 by M. Schmorde