


T.39S., R.12 & 13W., W.M.

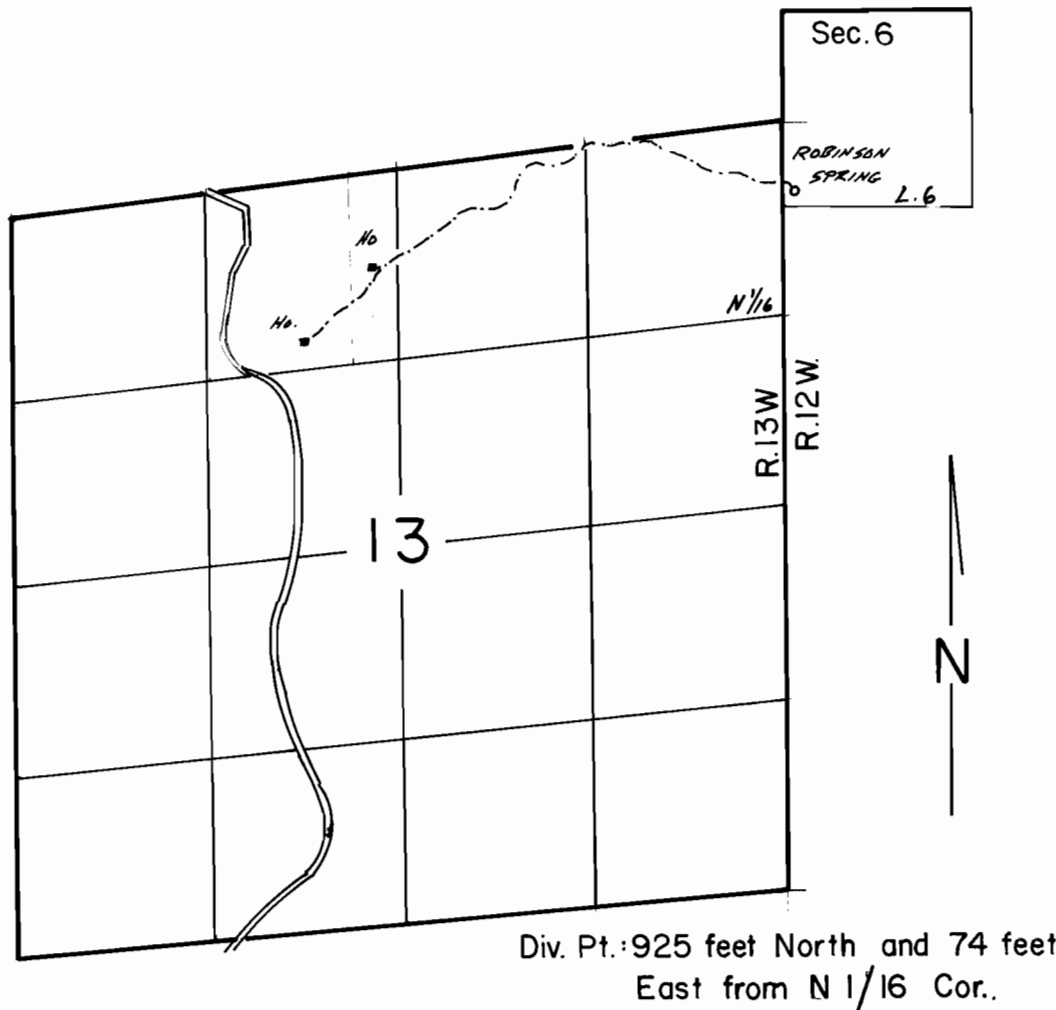

FINAL PROOF SURVEY
UNDER

Application No. 67973 Permit No. 48441....
IN NAME OF

HARVEY.....TIMEUS.....&.....BILL...GAGNON

Surveyed June. 3. 1993., by BS. JAMES.....