


T. 3 S., R. 2 E., W.M.

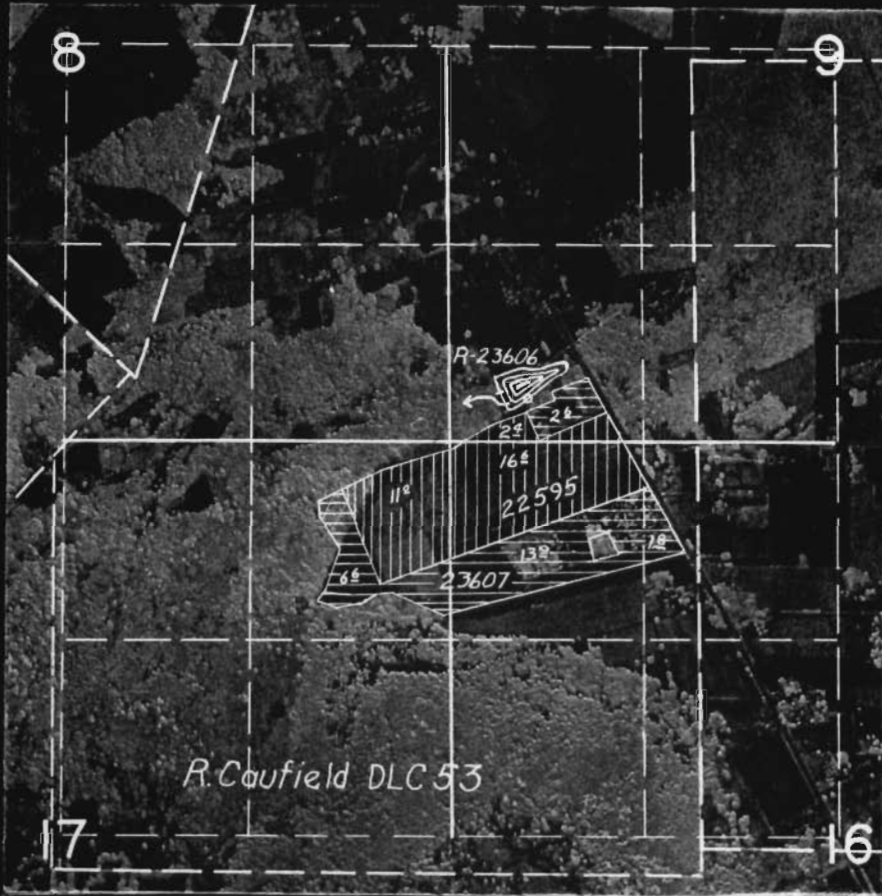

FINAL PROOF SURVEY
UNDER

Application Nos. Permit Nos.

22595
R-23606
23607

17917
R-976
18804

IN NAME OF
A. GUNTHER

Surveyed May 20 1953, by H. L. Coffman

DFK-3D-151