


T.2S.R.1W.W.M.

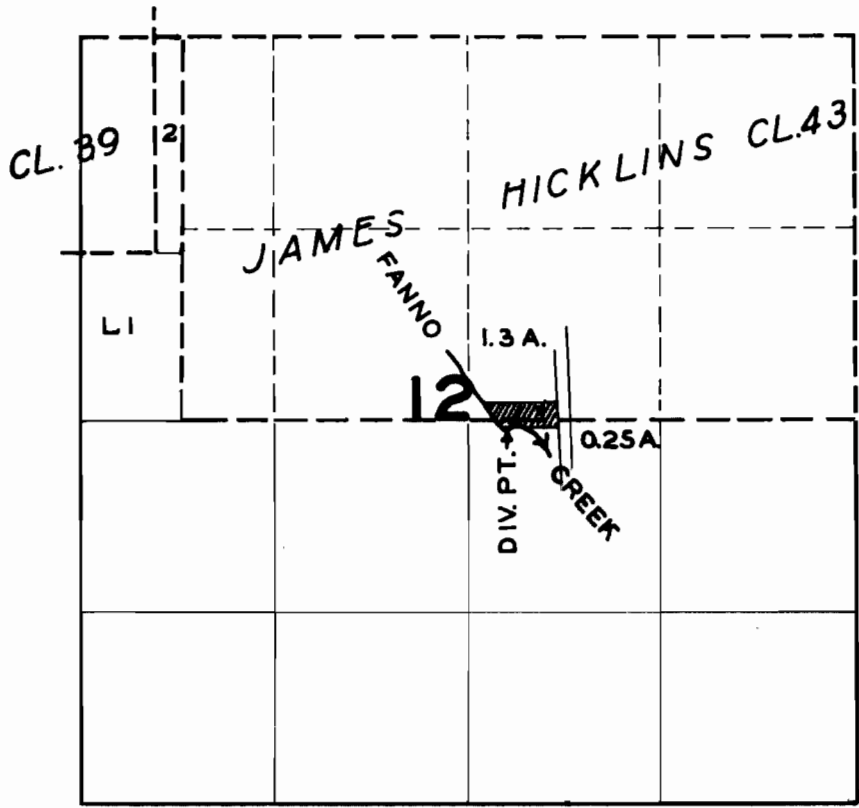

FINAL PROOF SURVEY UNDER

Application No. 24665 Permit No. 19406
IN NAME OF

S. E. LOVETT

Surveyed MAY 11 1951, by H. L. COFFMAN.