


T.2S.R.IW.W.M.

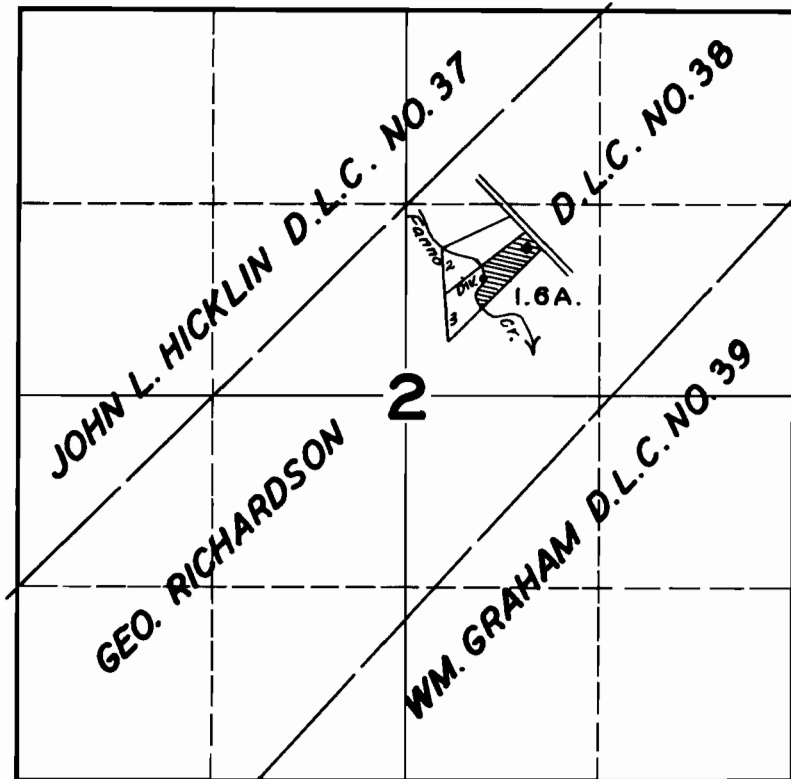

FINAL PROOF SURVEY

UNDER

Application No. **20509** Permit No. **16011**.....

IN NAME OF

DANIEL F. MOOTER.....

Surveyed **MAY 4**... 19**48**, by **JAS. E. BUNNELL**