


T.37 S., R.14 W., W.M.

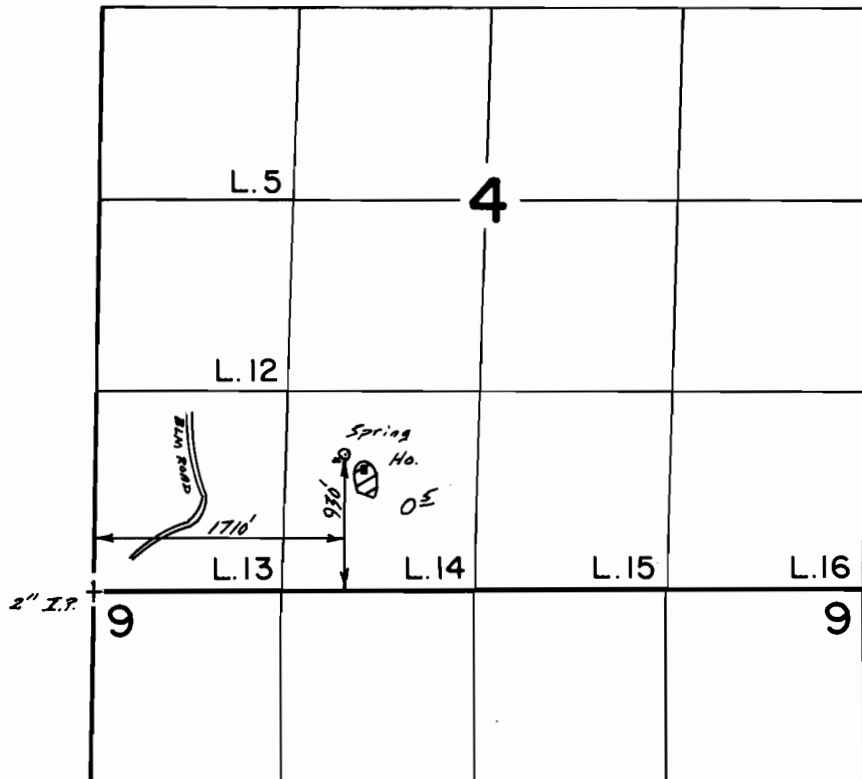

Scale 1"=1320'

FINAL PROOF SURVEY
UNDER

Application No. 58821.. Permit No. 44914.....
IN NAME OF

ALLAN... &/or... IRENE... CHRISTOPHERSON

Surveyed June..7.... 1990., by B.S. JAMES.....