

Application No. R-65111
Permit No. R 8230

R9230
75480

Form OR-010-7300-2
4/83

UNITED STATES
DEPARTMENT OF THE INTERIOR
BUREAU OF LAND MANAGEMENT

Section 14
SE 1/4 NE 1/4


Township 28 S
Range 24 E

Appl. No. _____

Permit No. _____

Will. Mer.

4" = 1 MILE

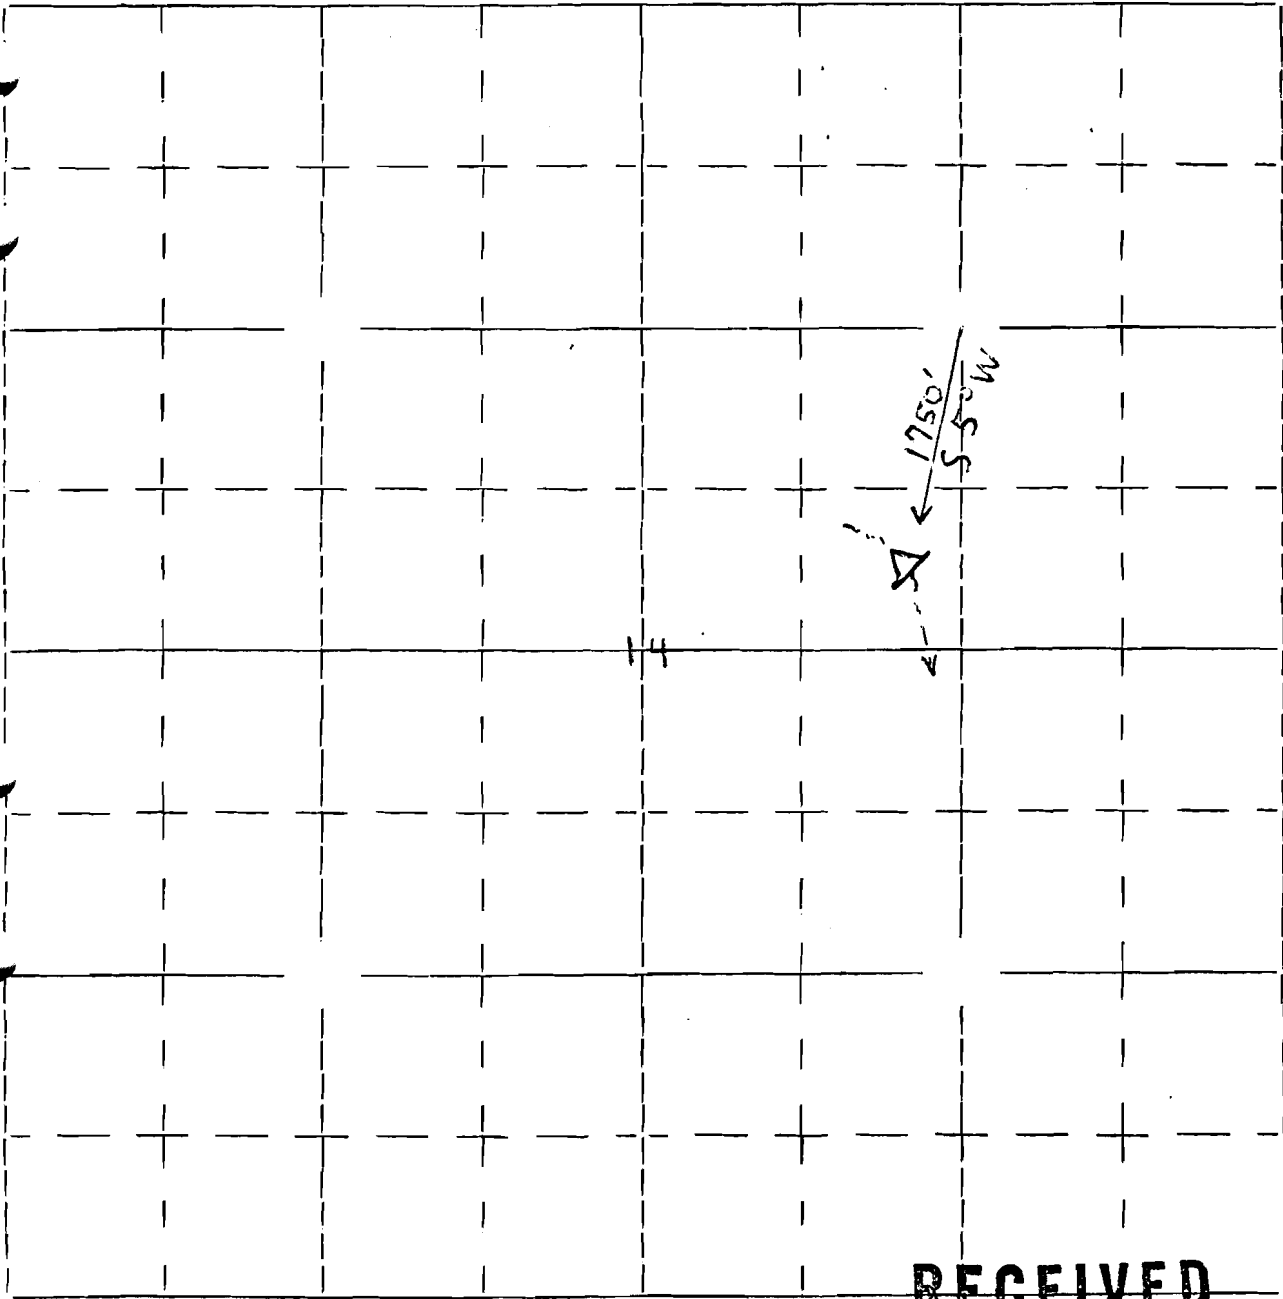

RECEIVED

MAY 19 1983

WATER RESOURCES DEPT.
SALEM, OREGON