

R9500
75482

Form OR-010-7300-2
4/83

UNITED STATES
DEPARTMENT OF THE INTERIOR
BUREAU OF LAND MANAGEMENT

Section 32

Township 40S

Appl. No. R67640

SWNW


Range 29E

Permit No. R 9500

4"=1mi.

Will. Mer.

West Dixon W.H. #4755

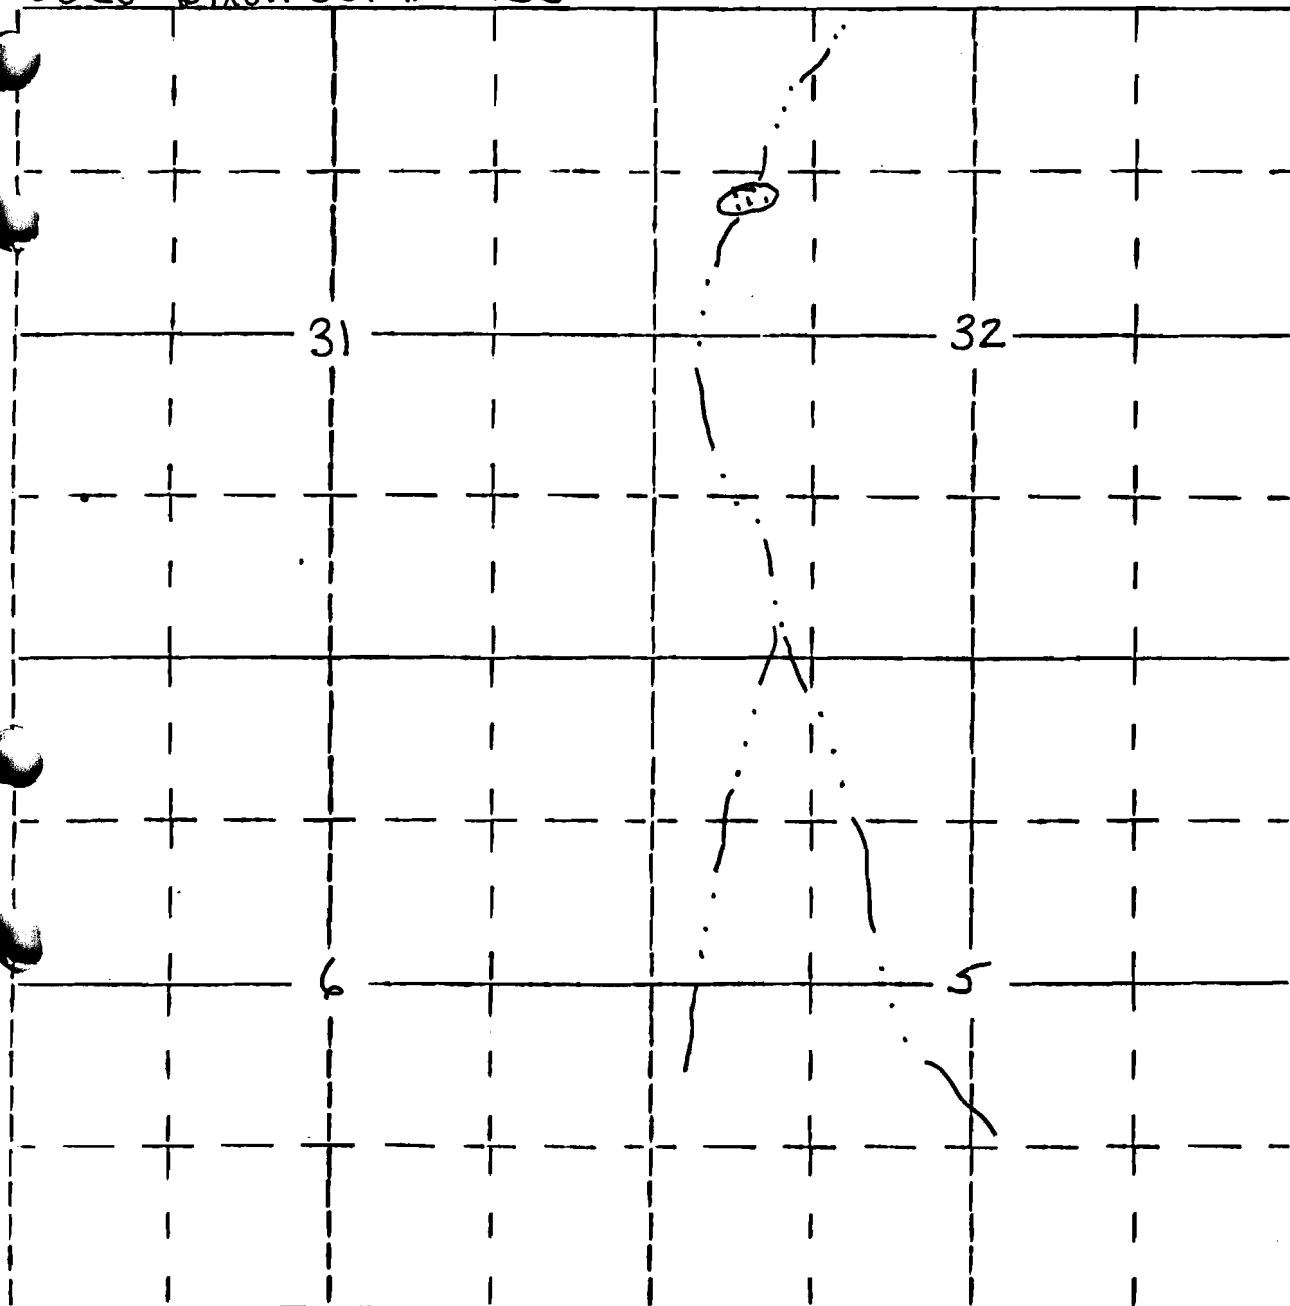

1,600' S 800' E of the NW corner of section 32

END