


T. 33 S., R. 1 W., W. M.

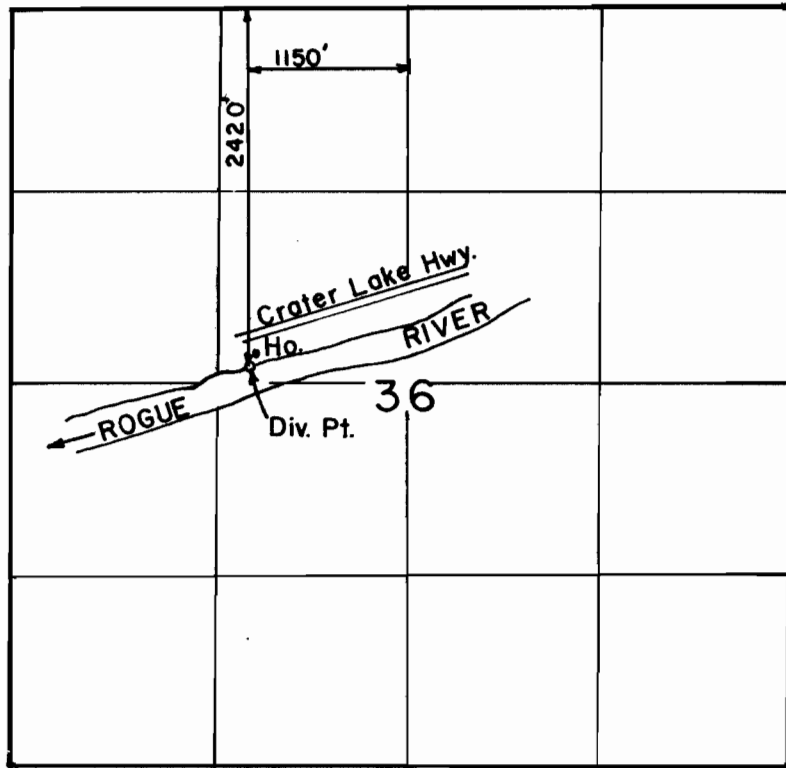

Scale: 1" = 1320'

FINAL PROOF SURVEY
UNDER

Application No. ~~68216~~ Permit No. ~~49267~~...
IN NAME OF

...ROY & BARBARA MUCKEY...

Surveyed JULY 16, 1991, by R. S. JAMES...