


T. 2 S., R. 1 W., W. M.

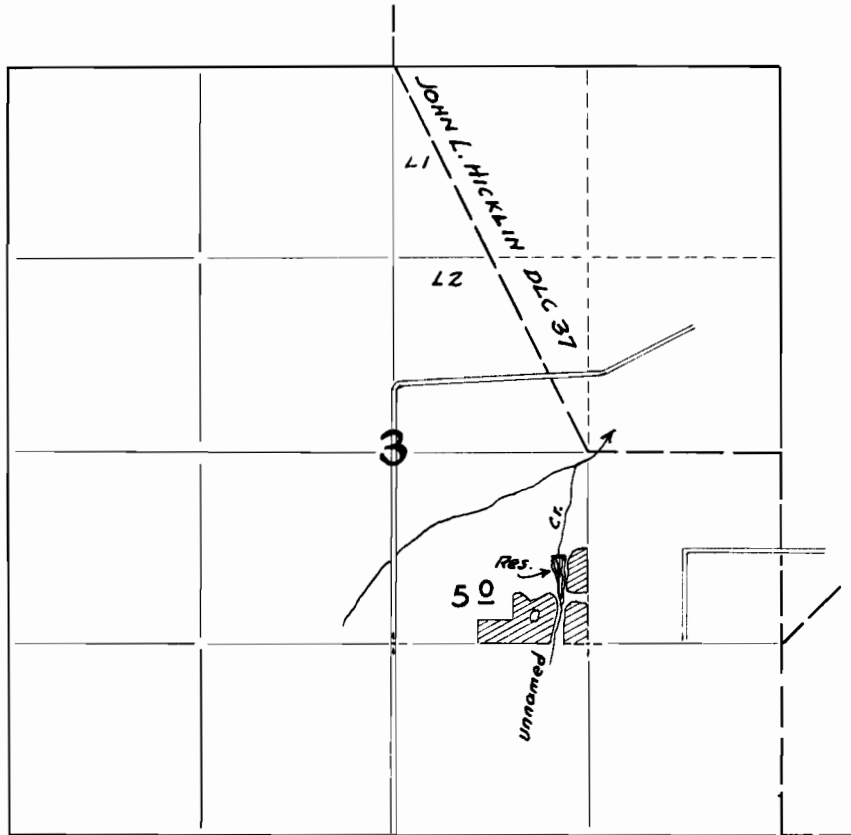

FINAL PROOF SURVEY

UNDER

R-26360

R-1243

Application No. 26361 Permit No. 20681

IN NAME OF

CURTIS C. TIGARD

Surveyed 5-4-1956 by M. BISH