


T. 2S. R. 1W. W.M.

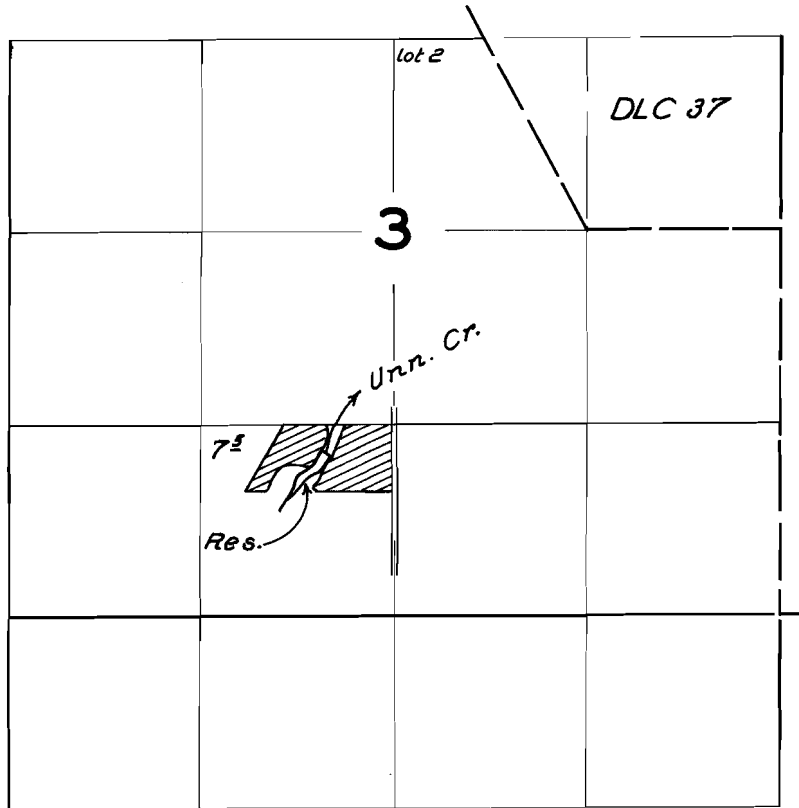

FINAL PROOF SURVEY
UNDER

Application No. *R27444* *R1397*
27597 Permit No. *21649*
IN NAME OF

Jack Warnstaff

Surveyed *Sept. 15* 1959, by *C.O. Bartels*