


UNITED STATES
DEPARTMENT OF THE INTERIOR
BUREAU OF LAND MANAGEMENT

SECTION

Oregon State Water Filings

TOWNSHIP 29S, RANGE 15E, W. M.

North COTTONWOOD SPRING RESERVOIR

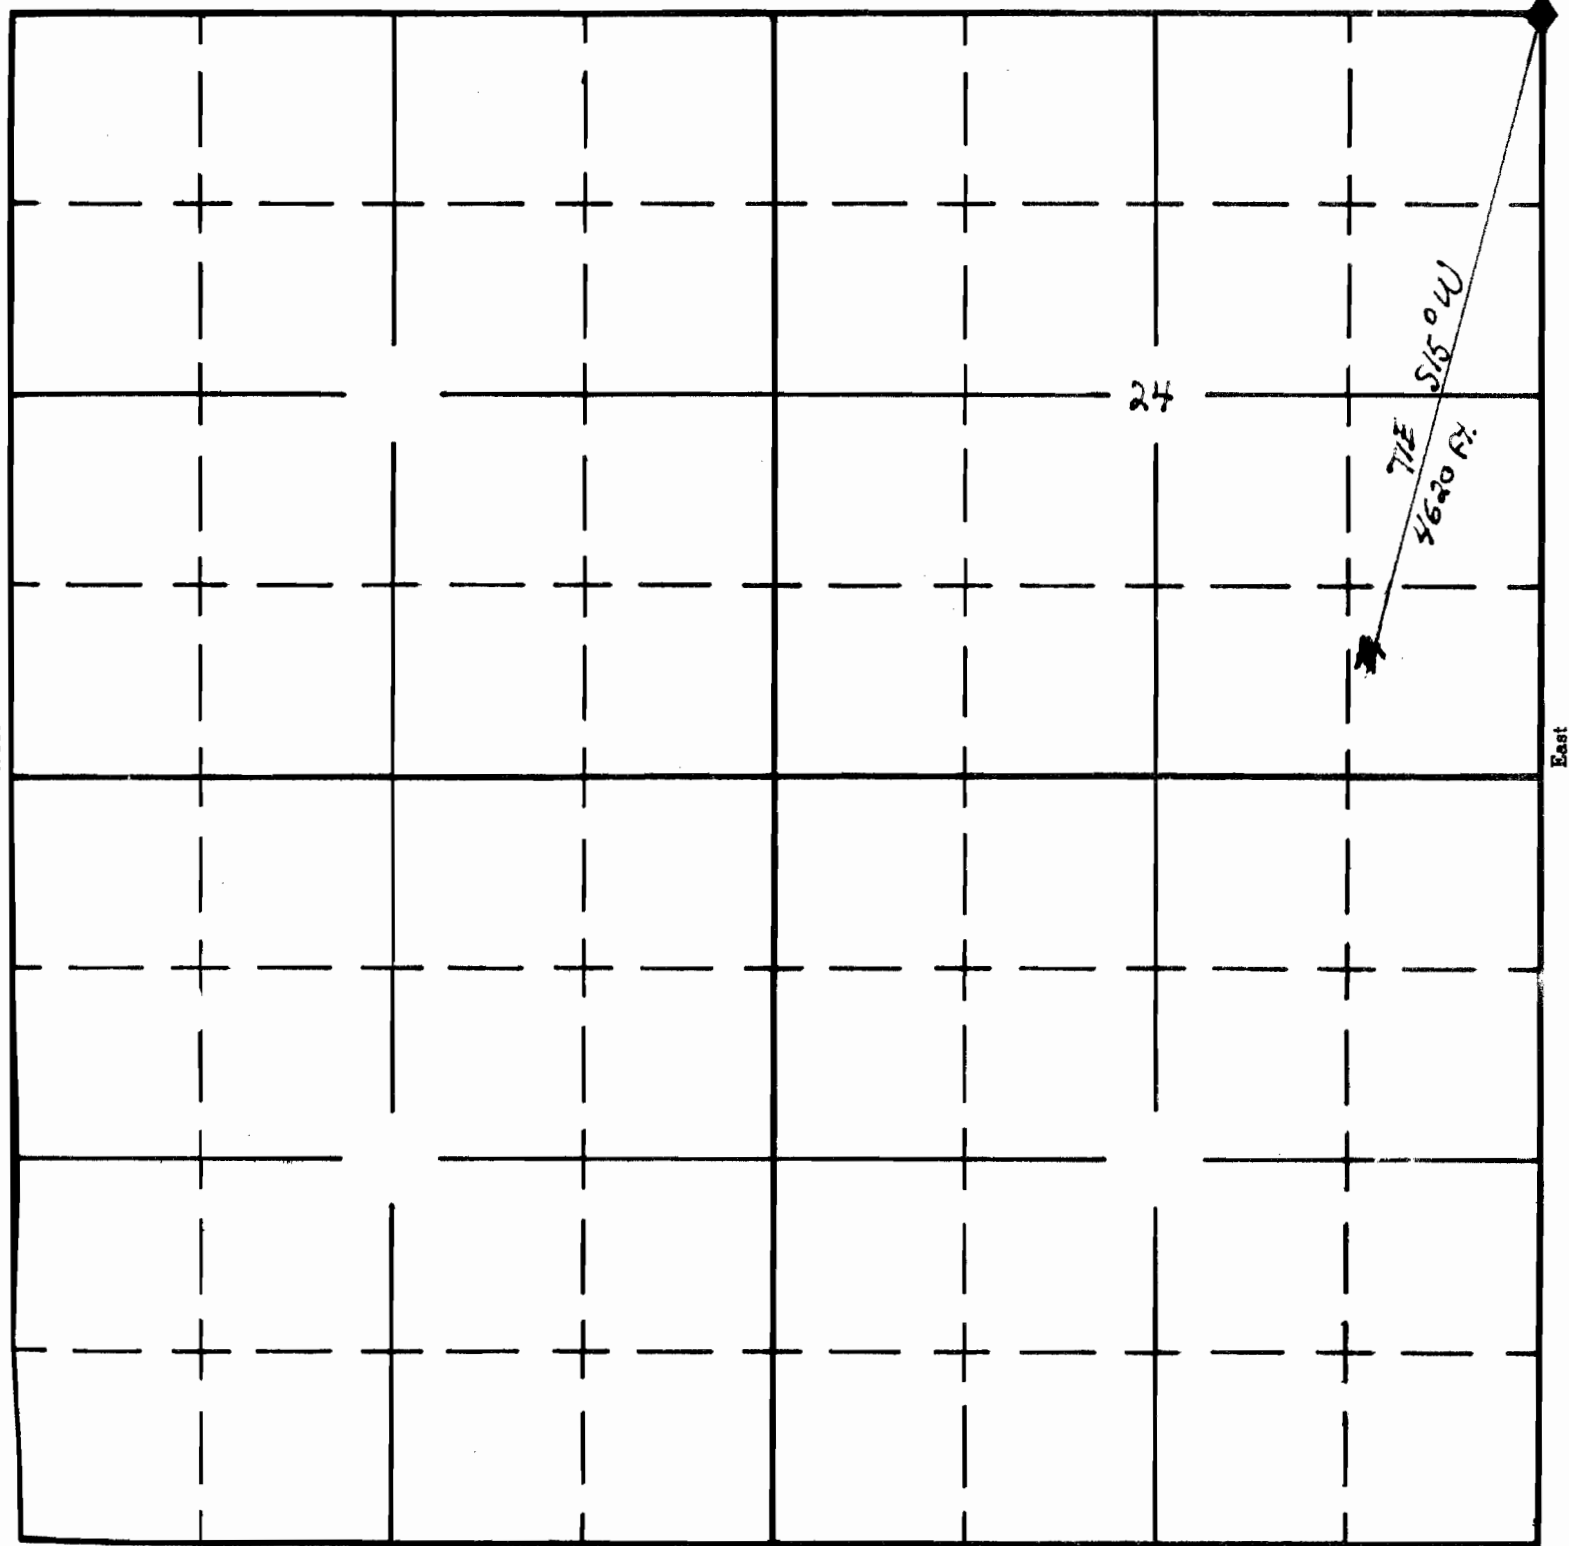

◆ FOUND SURVEY CORNER.

South

W PROJECT

APPLICATION No. R-34362
PERMIT No. R-2539