

Form AI-187
March 1961

UNITED STATES
DEPARTMENT OF THE INTERIOR
BUREAU OF LAND MANAGEMENT


SECTION
15

Oregon State Water Filings

SW 1/4 NW 1/4

TOWNSHIP 29S, RANGE 16E, W. M.

Tied in with aerial photos & O.S.H.D. Quad Maps

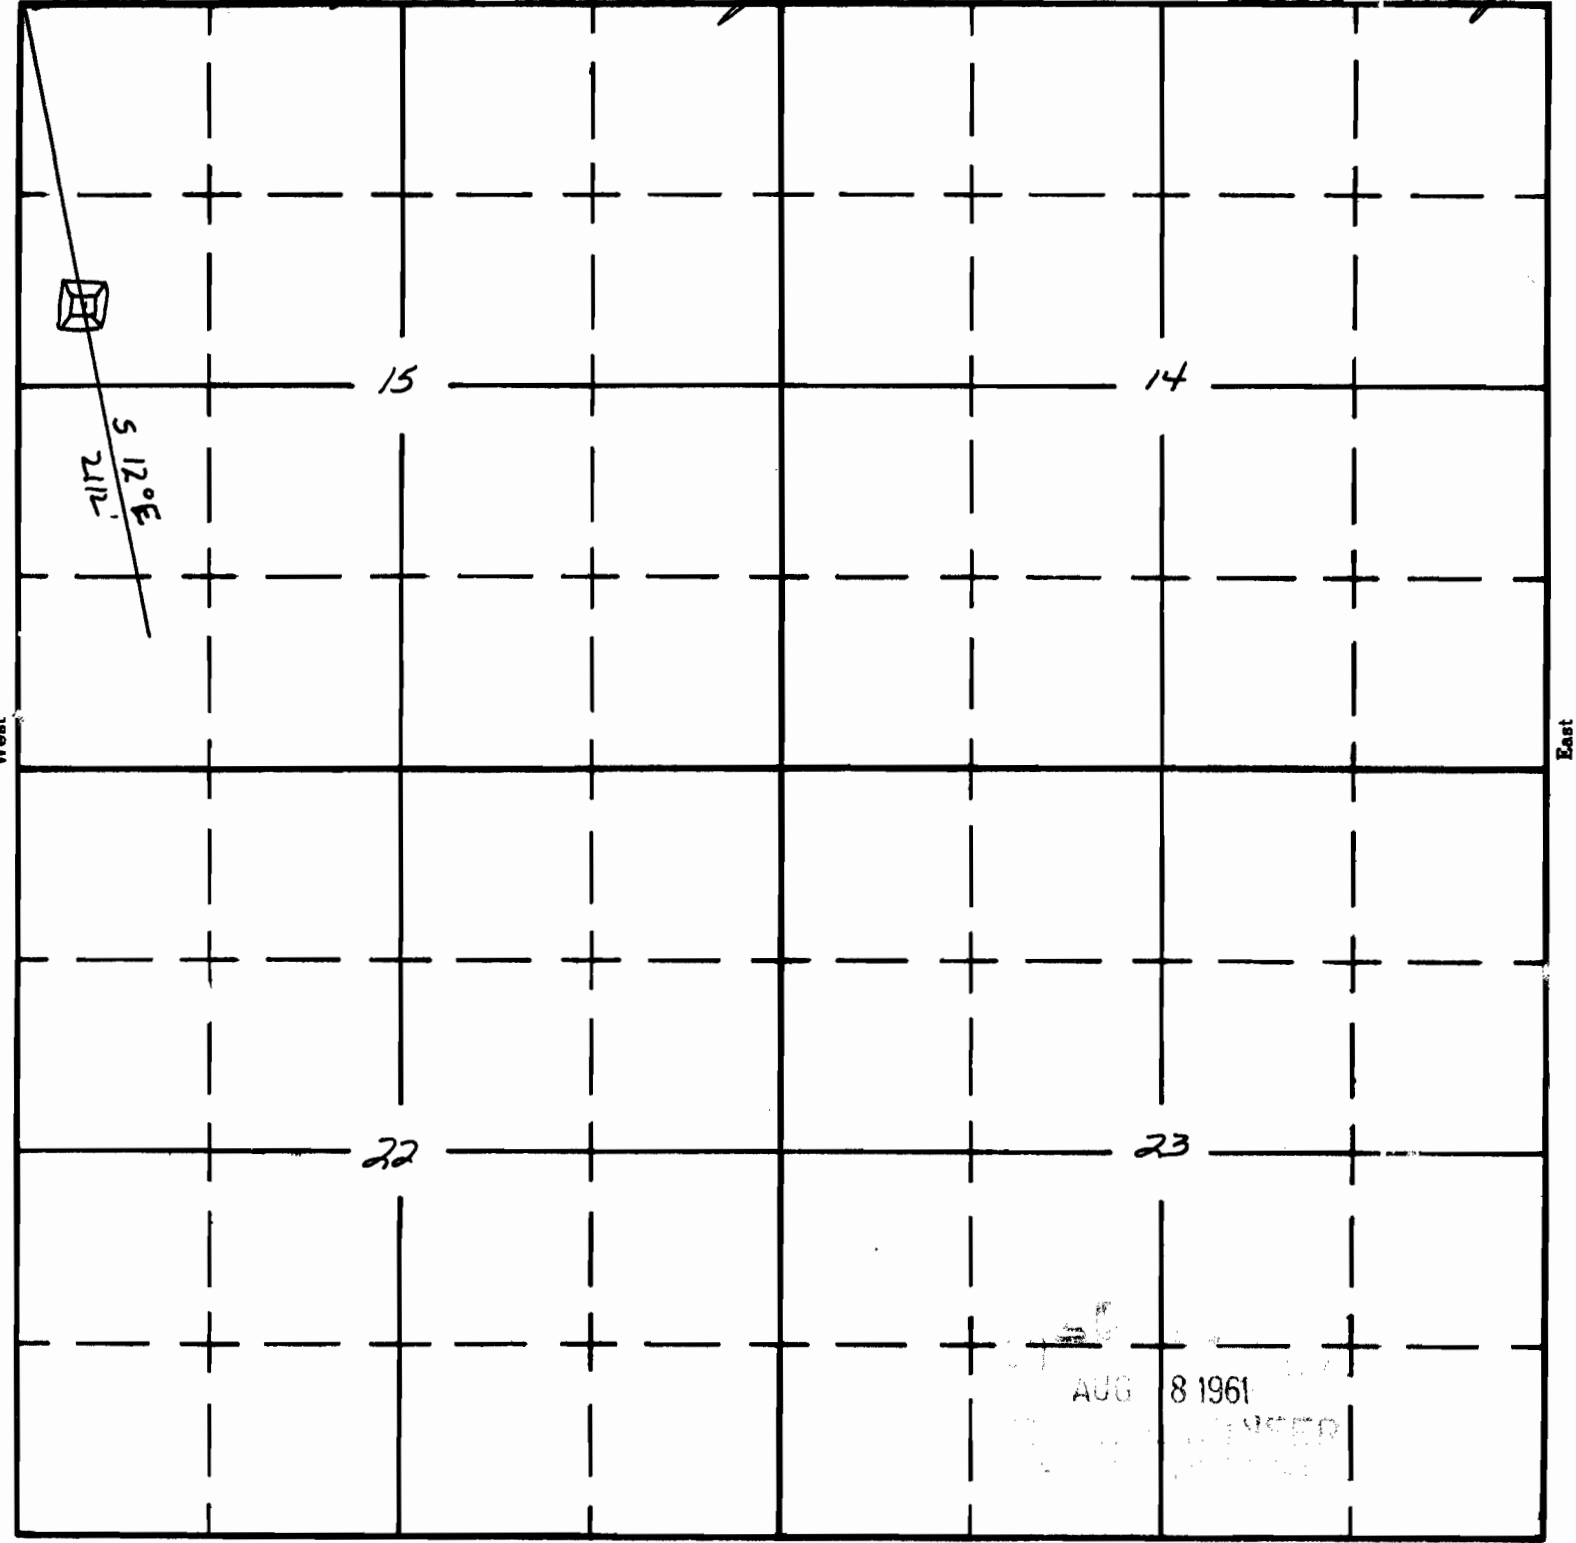

AUG 8 1961
RECEIVED

APPLICATION No. R-36568
PERMIT No. R 7239