


T. 15 S., R. 11 W., W.M.

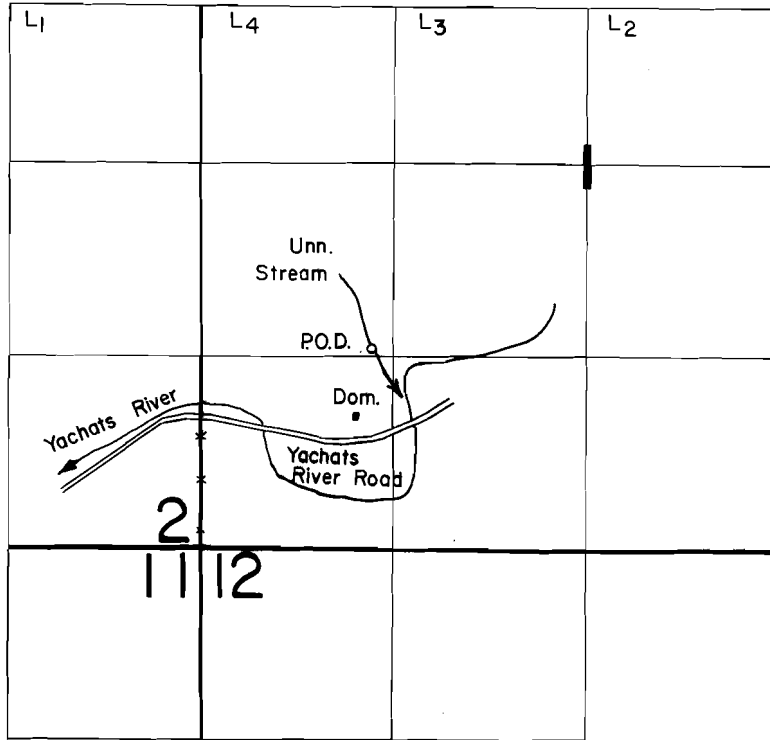

P.O.D. Loc.: 1370' N. & 1180' E. from SW Cor. Sec. 1

Scale: 1" = 1320'

FINAL PROOF SURVEY UNDER

Application No. 64153 Permit No. 47068
IN NAME OF

MARK & ANN THOMPSON

Surveyed Nov. 15, 1989, by T. Warren