

18


STOCK WATER SPRING CR. allotment

FS Temporary Id. # 83Pφ1
SCALE 4 IN. : 1 MILE

North ↑

application no. 67461

permit no. 50494

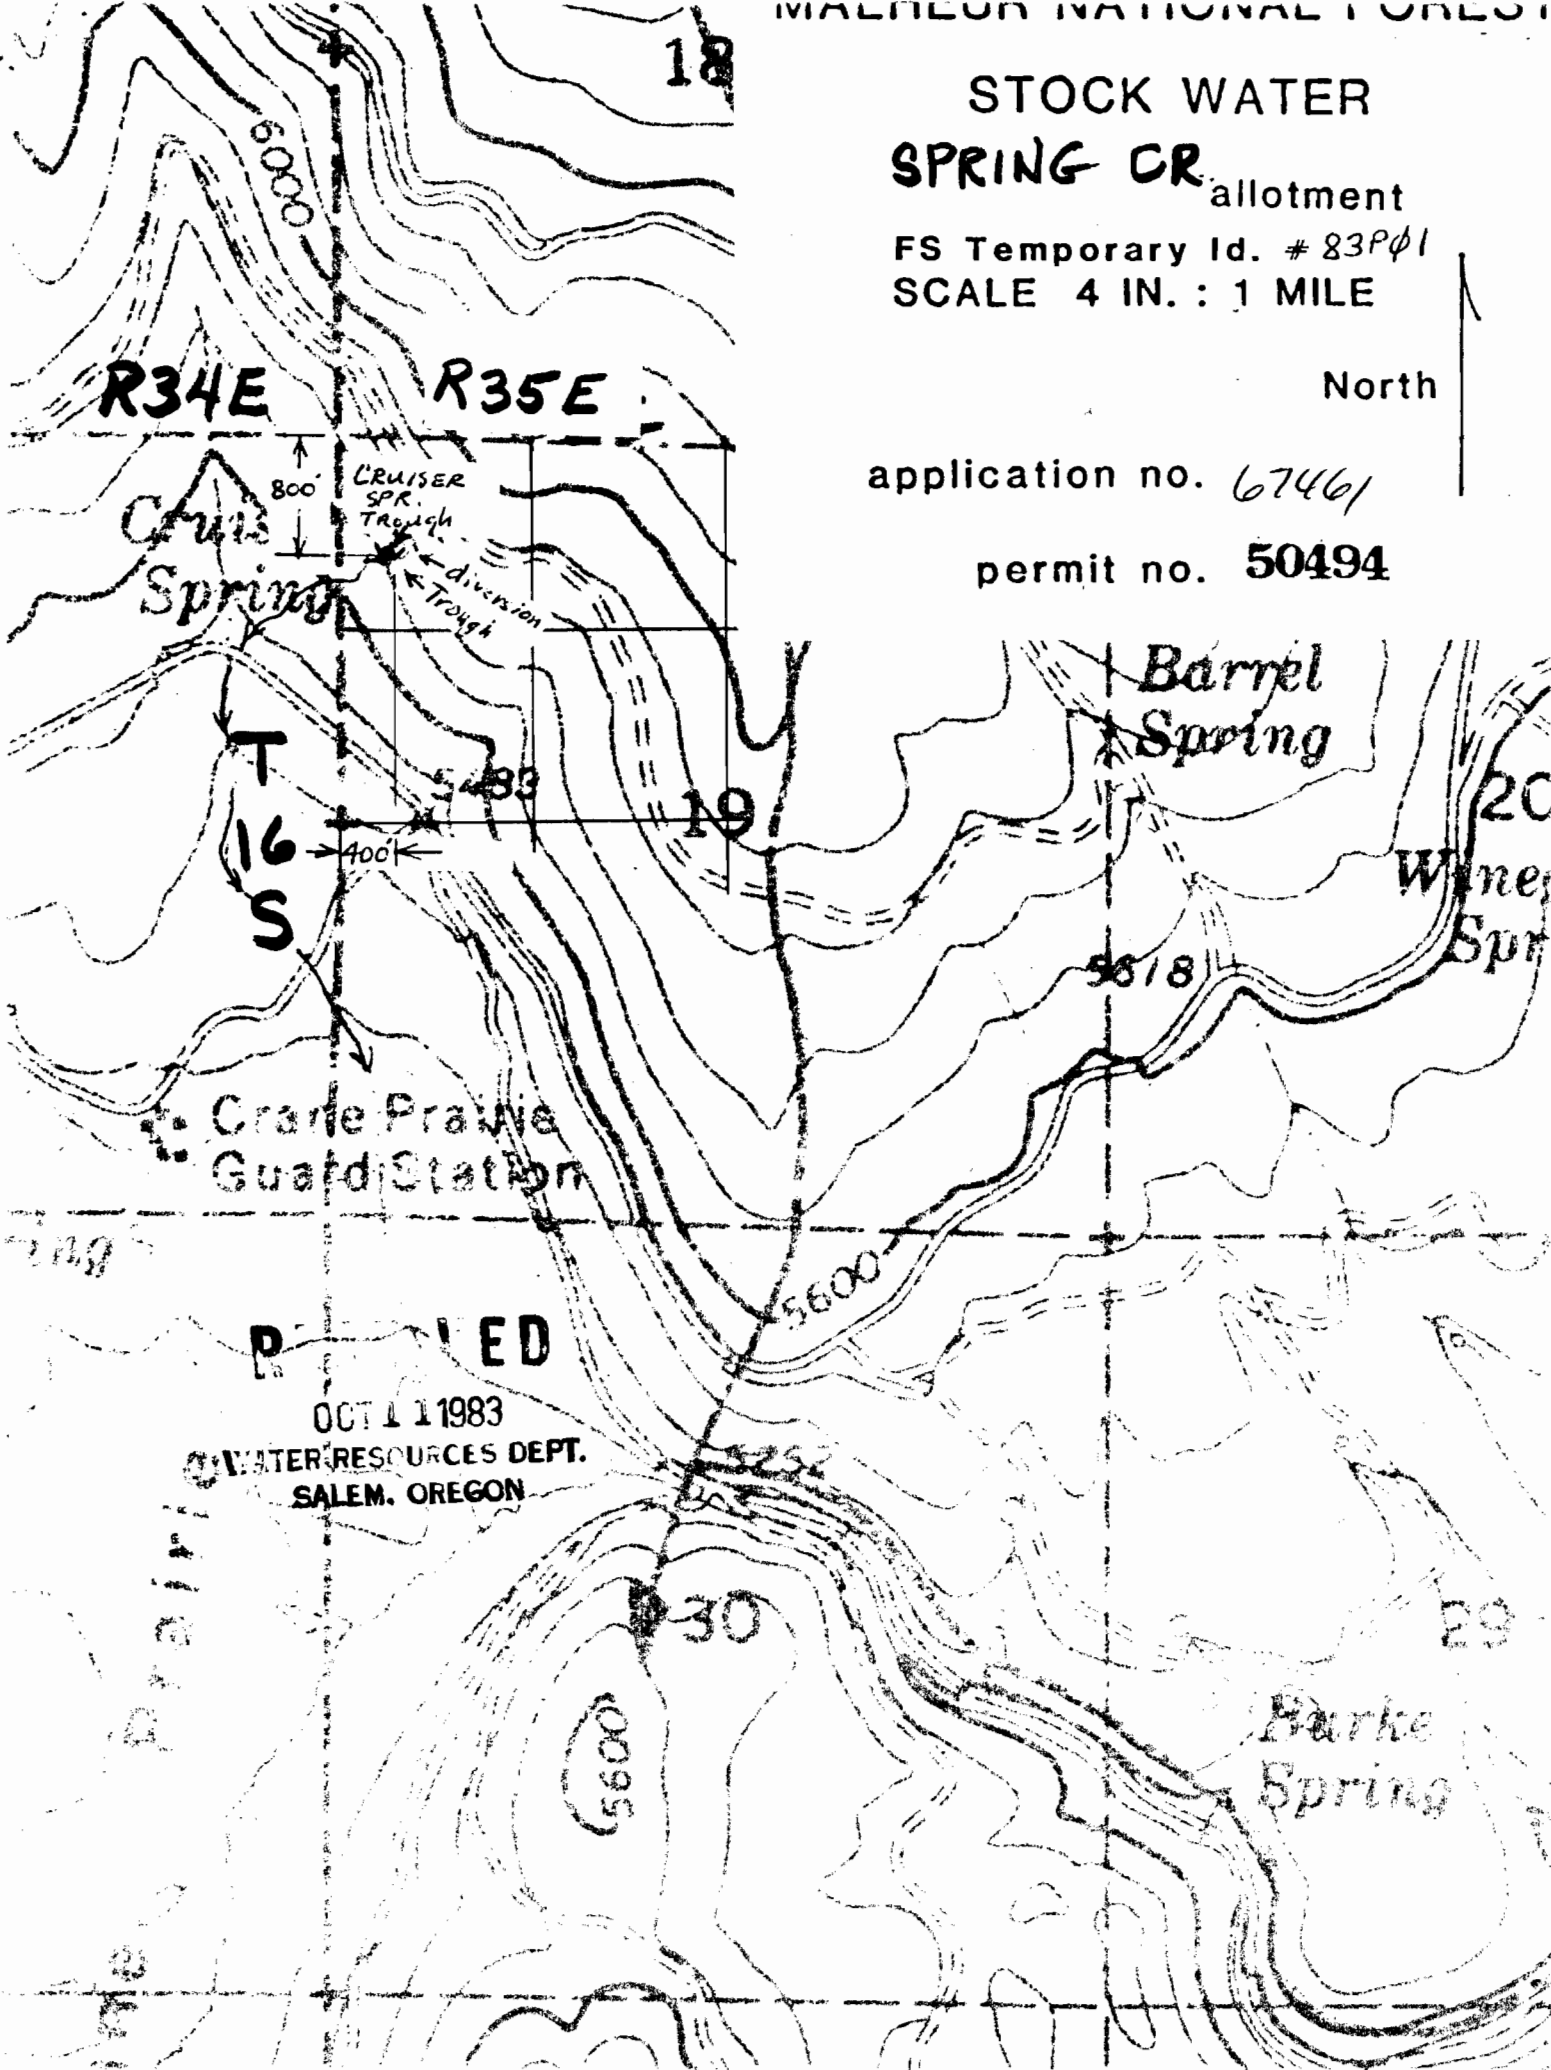

RECEIVED

OCT 11 1983

WATER RESOURCES DEPT.
SALEM, OREGON

Arctic