


App. No. R-73515
Permit No. 73512
"CERTIFICATE NO. ~~63918~~"

SECTION 13

SW $\frac{1}{4}$ SE $\frac{1}{4}$ TOWNSHIP 22S RANGE 42E W.M.

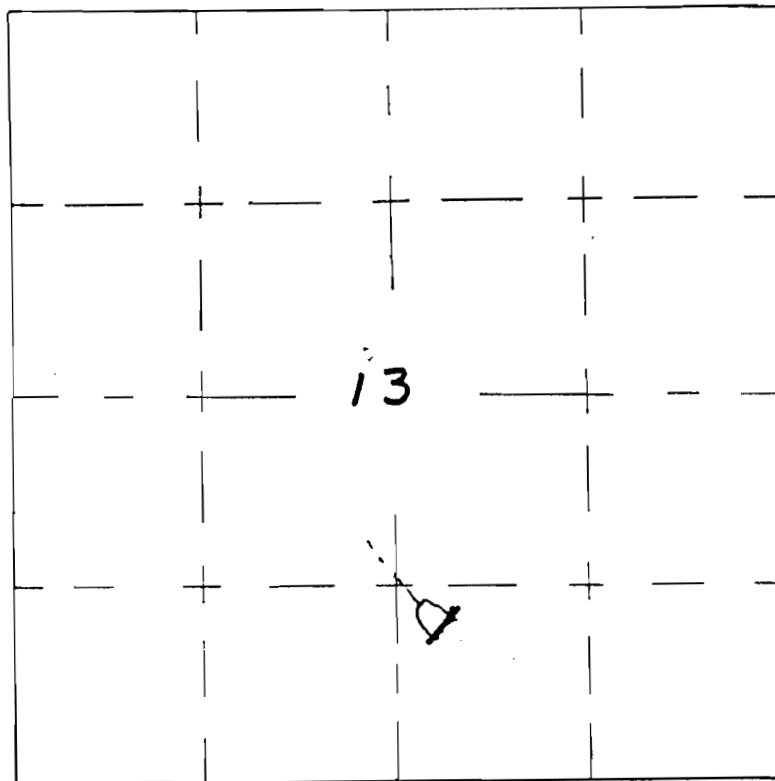

Spotted Horse
NOR 59054

Permit No. R 8700