


T.32S., R. 5W., W. M.

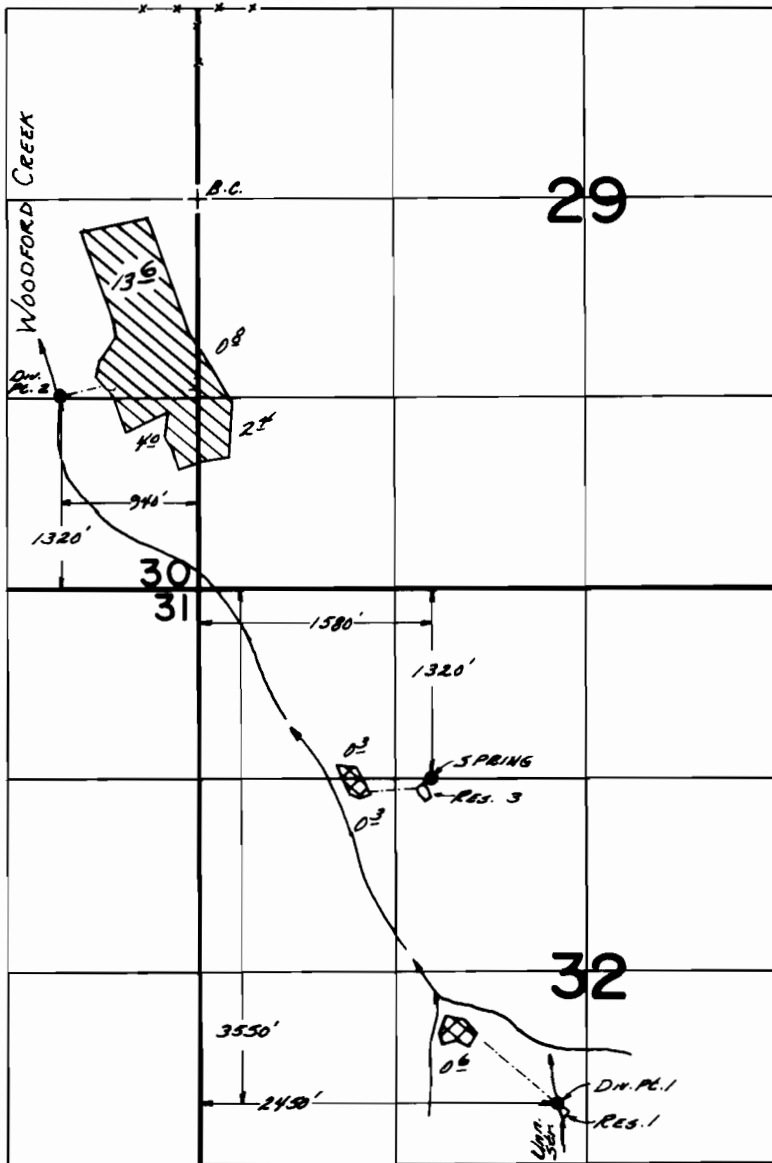

FINAL PROOF SURVEY

UNDER

TRANSFER No. 2340

R-46697

R-5598

Application No. 45832, Permit No. 34948... → *Supplements!*

IN NAME OF

...NEW...EDUCATION...FOUNDATION...

Surveyed May...22. 1975., by L.H.Nunn.....