


T. 32S., R. 5W., W. M.

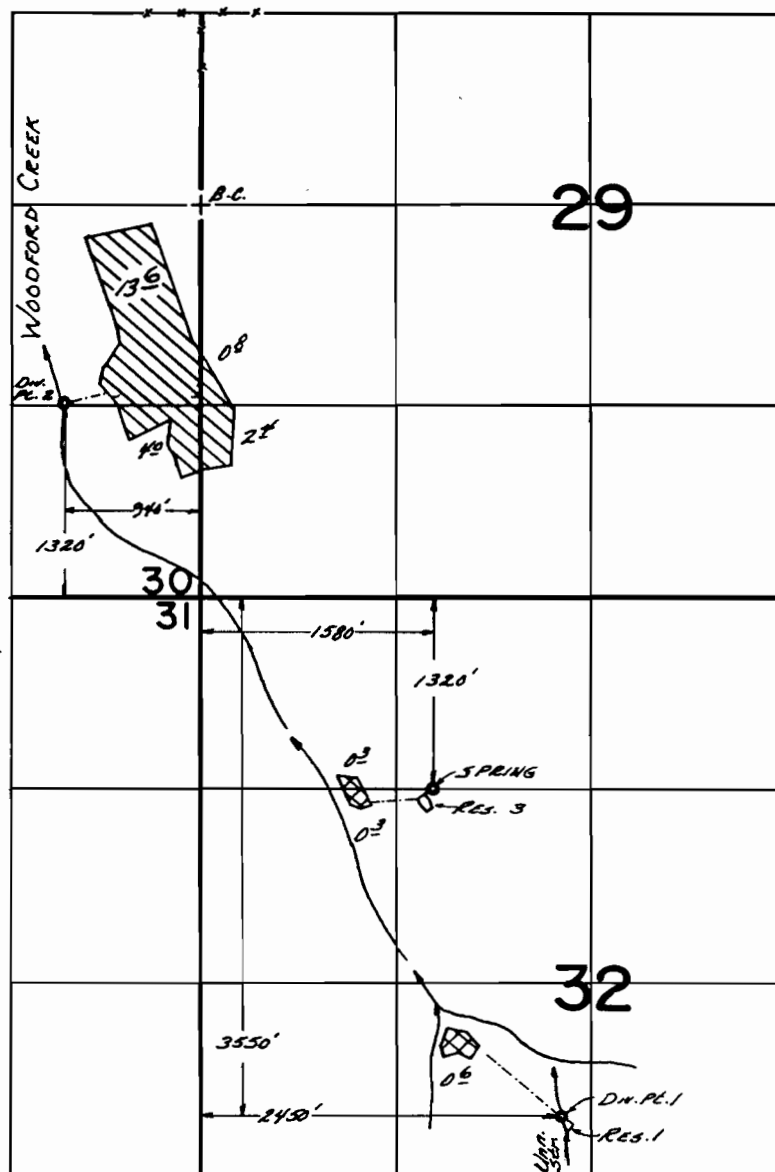

**FINAL PROOF SURVEY**  
UNDER

TRANSFER No. 2340  
R-46697 R-5598  
Application No. 45832. Permit No. 34948. Supplemental  
IN NAME OF

...NEW EDUCATION FOUNDATION...

Surveyed May..22. 1975., by L.H. Nunn.....