


T.5S., R.1W., W.M.

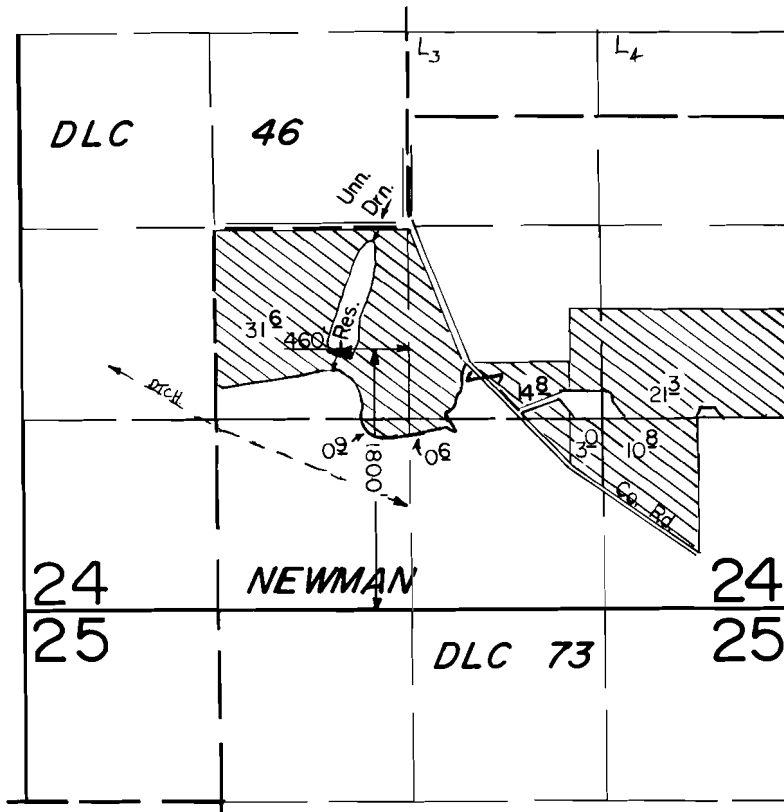

Scale: 1" = 1320'

FINAL PROOF SURVEY UNDER

R-55485

R-6573

Application No. 55486... Permit No. 41509.....

IN NAME OF

VAN VEEN NURSERIES, INC.

Surveyed JULY 16, 1985, by T. Warren.....

DFK-2LL-24
41005-278-139 D
DFN-3LL-172

CORRECTED  T.M.W.