


UNITED STATES  
DEPARTMENT OF THE INTERIOR  
BUREAU OF LAND MANAGEMENT

SECTION  
20 NESE  
\_\_\_\_\_  
\_\_\_\_\_  
\_\_\_\_\_


TOWNSHIP 23 S, RANGE 38 E, W. M.

North EASTERDAY RES.

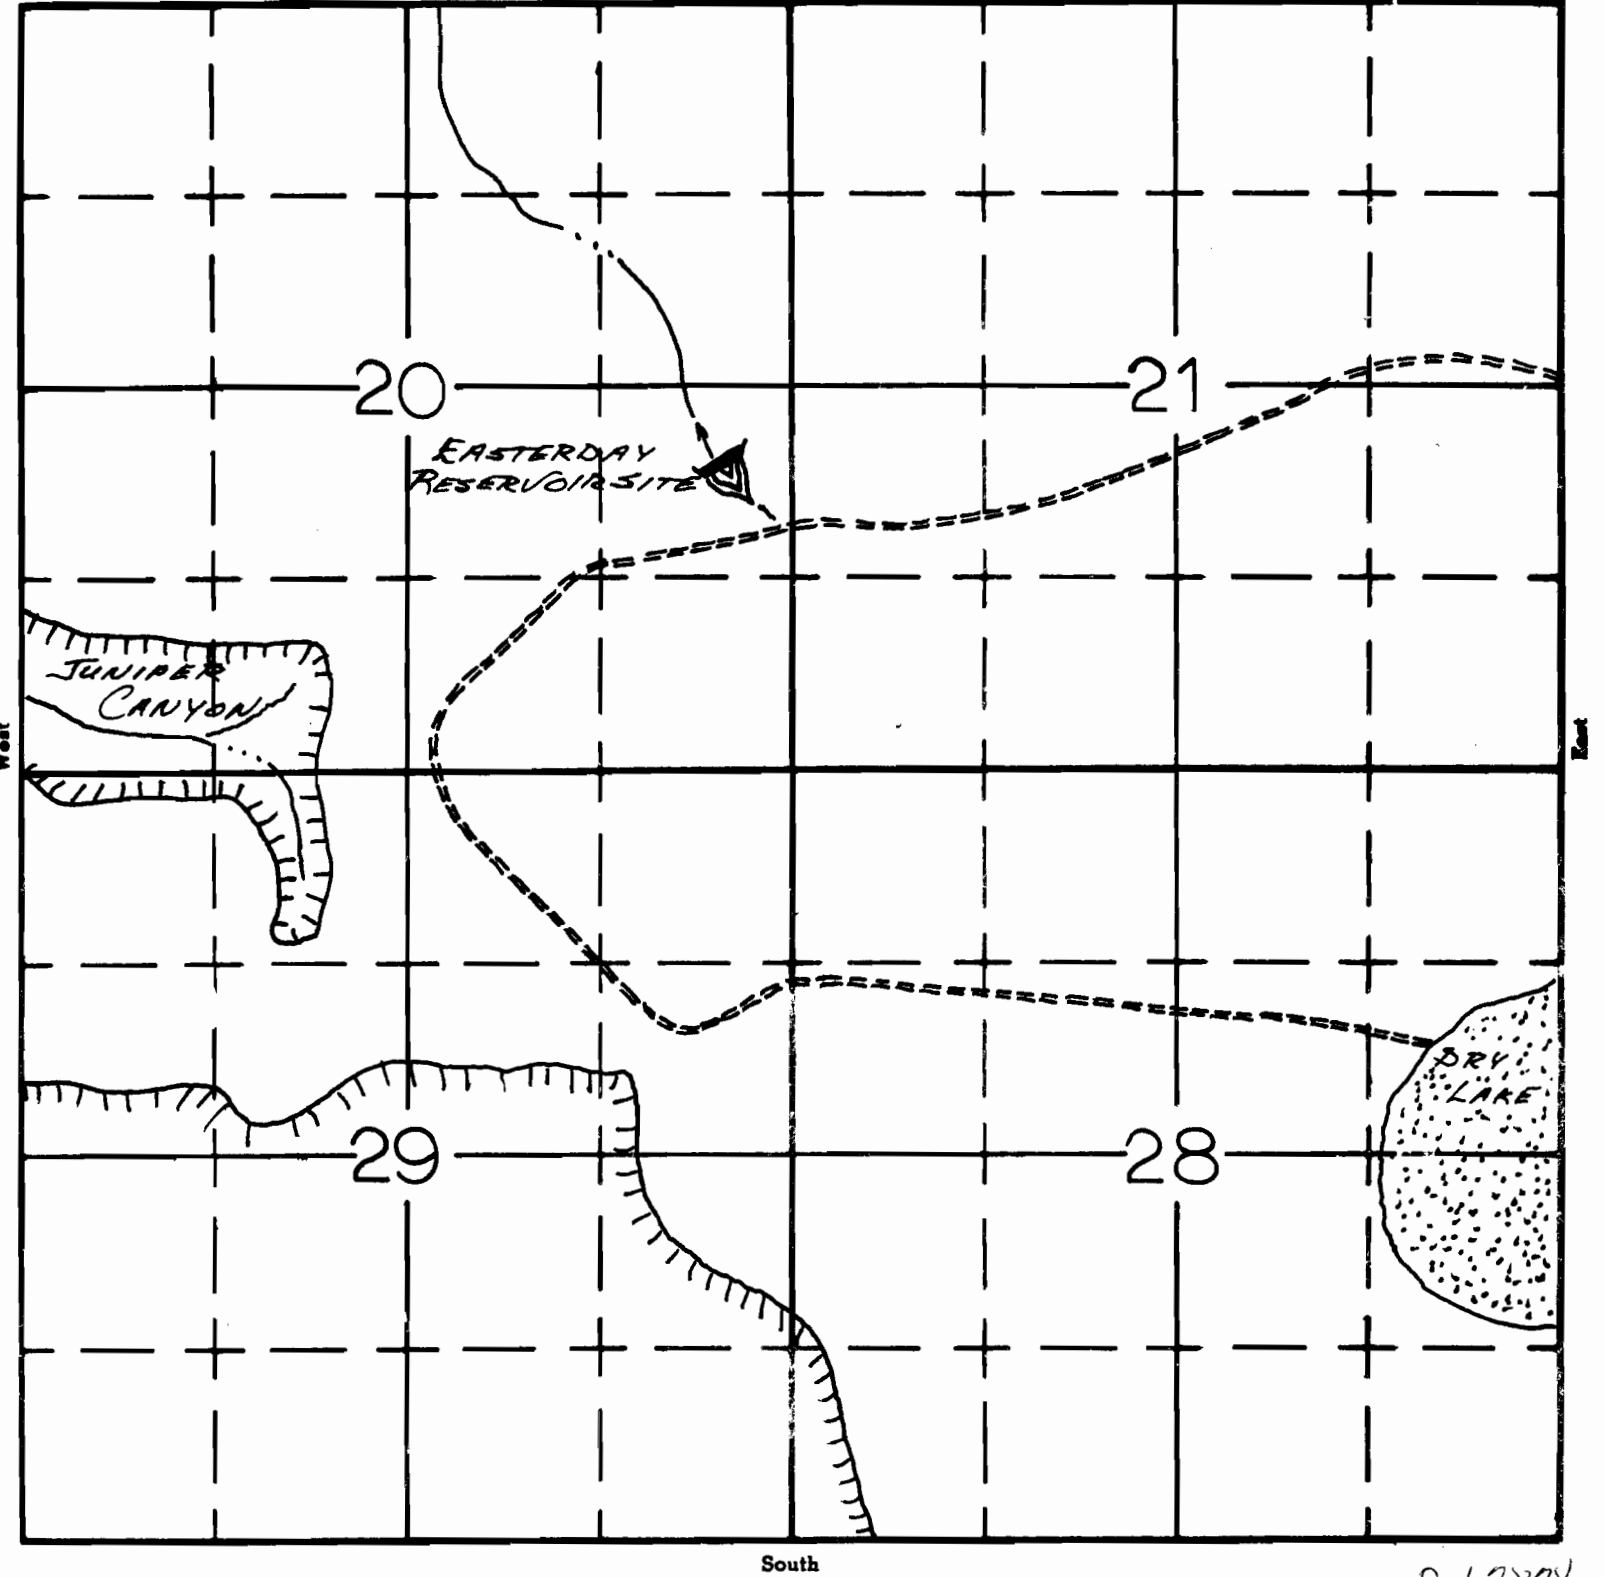

South

APPLICATION No. R-67878  
PERMIT No. R10686