


T.4S.,R.1W.,W.M.

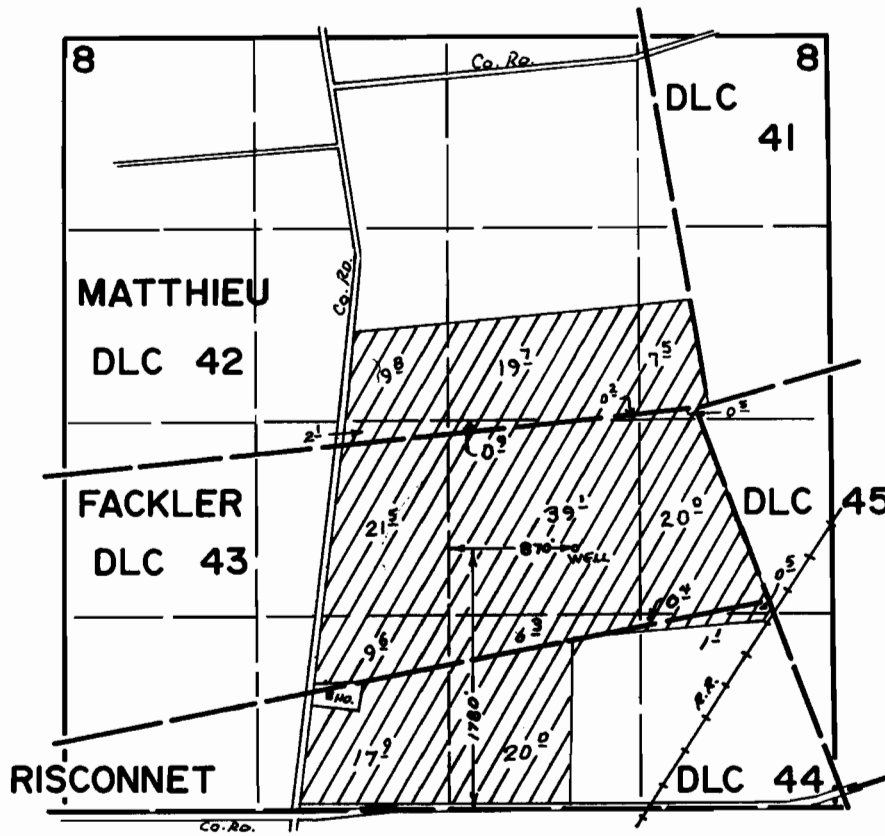

FINAL PROOF SURVEY UNDER

Application No. G-5823 Permit No. G-5574
IN NAME OF

PAUL E. SINGER, JR.

Surveyed April 16, 1976, by L. Teal