


G.912612
53458
75534
T6864

T.26S., R.16E., W.M.

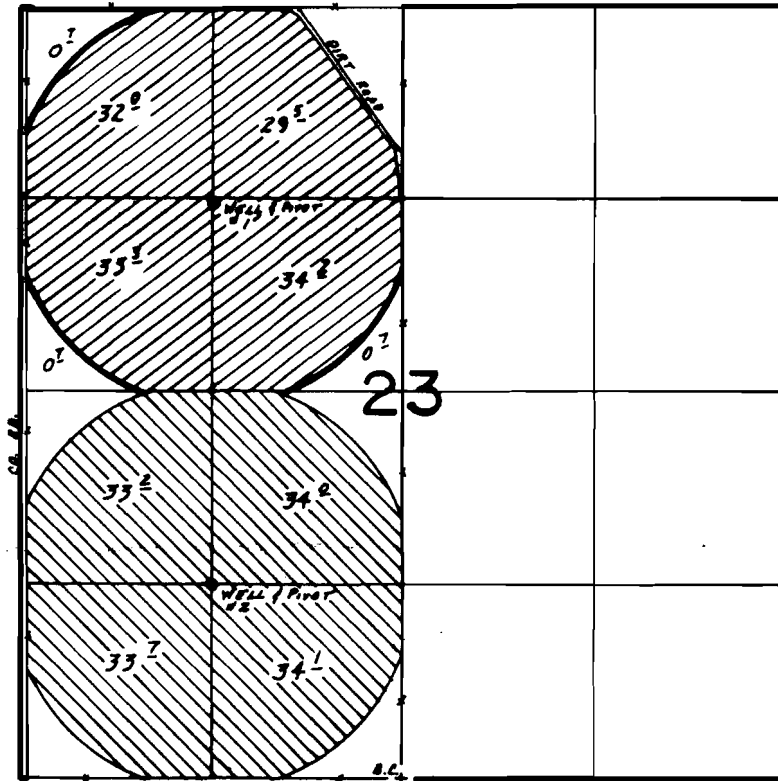

WELLS LOC: #1- 3940' N. of 1320' W. #2- 1320' N. of 1320' W. BOTH FROM S 1/4 COR. SEC. 23.



WELL No. 1
WELL No. 2

SCALE: 1" = 1320'

FINAL PROOF SURVEY UNDER

Application No. G-10097. Permit No. G-9126.....
IN NAME OF

.....VERL E. NOFZIGER.....

Surveyed OCT. 29. 1984, by B.W. BISHOP.....