


G.9127
53459
75535
T6864

T.26S.,R.16E.,W.M.

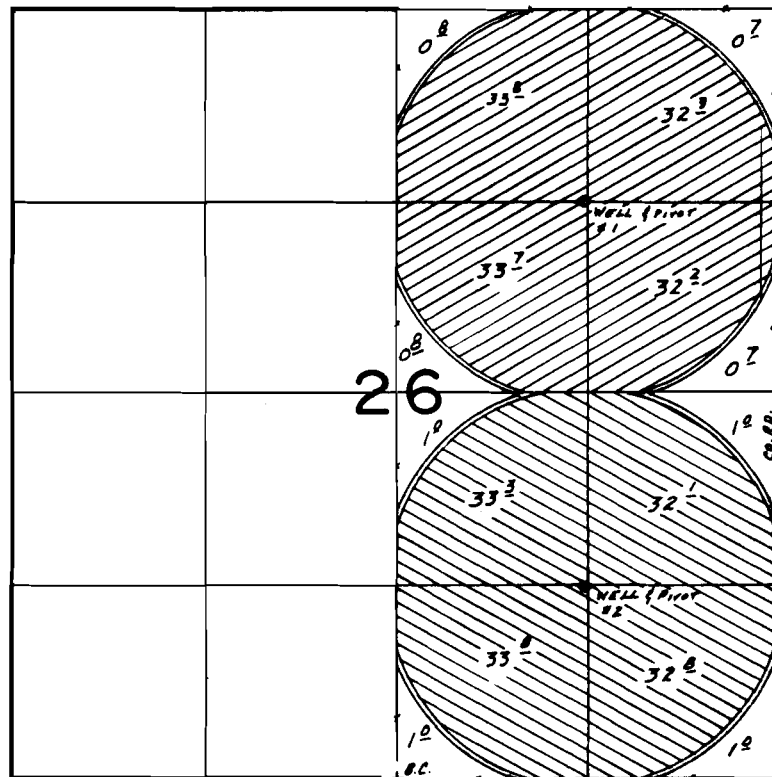

WELLS LOC: #1- 3960' N. & 1300' E., #2- 1310' N. & 1300' E., BOTH FROM THE S 1/4 COR. SEC. 26.

-  WELL No. 1
-  WELL No. 2

SCALE: 1"=1320'

FINAL PROOF SURVEY UNDER

Application No. G.:JQQ98 Permit No. G.:9127.....
IN NAME OF

.....VERL E. NOFZIGER.....

Surveyed OCT. 29. 1984., by B.W. BISHOP.....