


T.27 S.R.16 E.W.M.

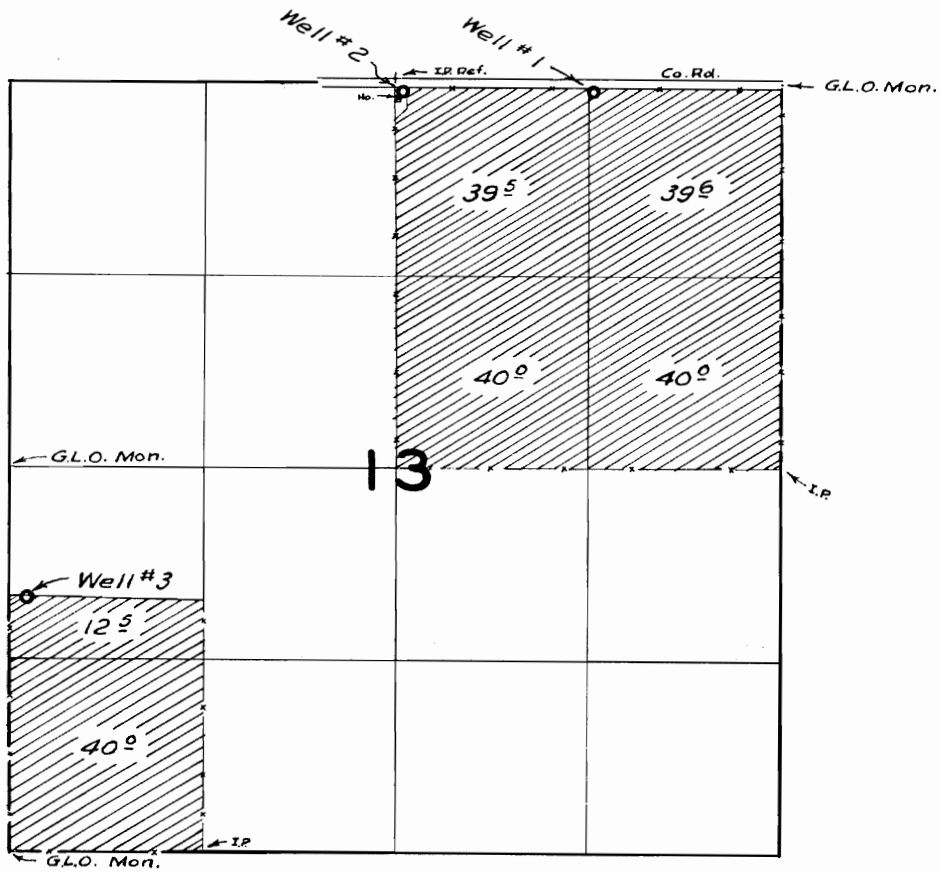

FINAL PROOF SURVEY UNDER

Application No. U-742 Permit No. U-664
IN NAME OF

A.E. Albertsen

Surveyed 13 May 1959, by M. B. Bish