


T.27S.,R.16E.,W.M.

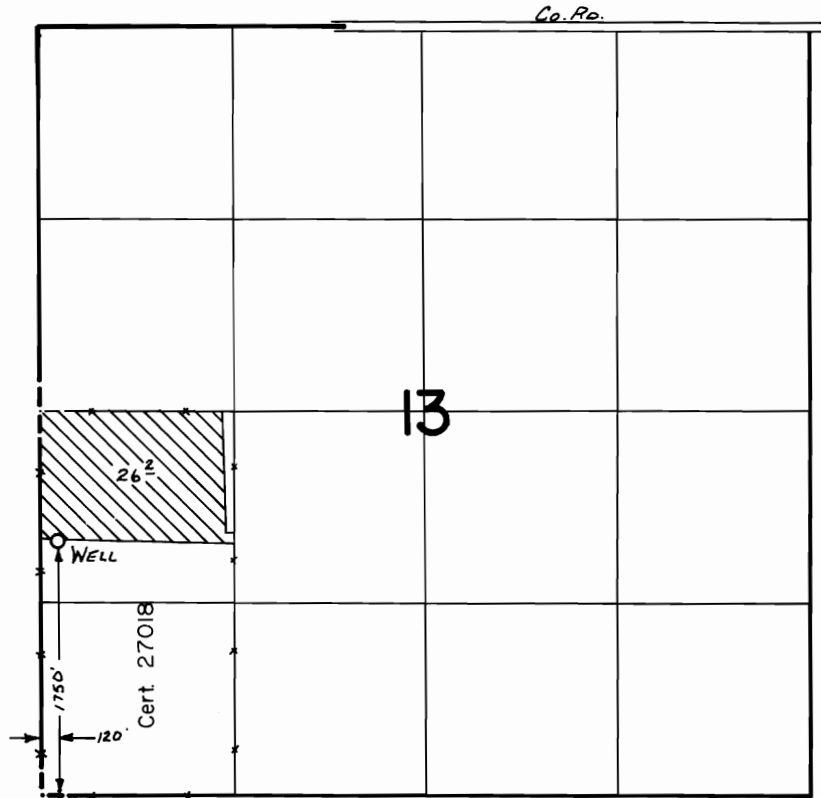

**FINAL PROOF SURVEY**  
UNDER

Application No. G-1023. Permit No. G-9264.....  
IN NAME OF

.....**ERNEST P. TUCKER**.....

Surveyed July..23... 19.83., by ...L.M.TOLL.....