


T.25S., R.19E., W.M.

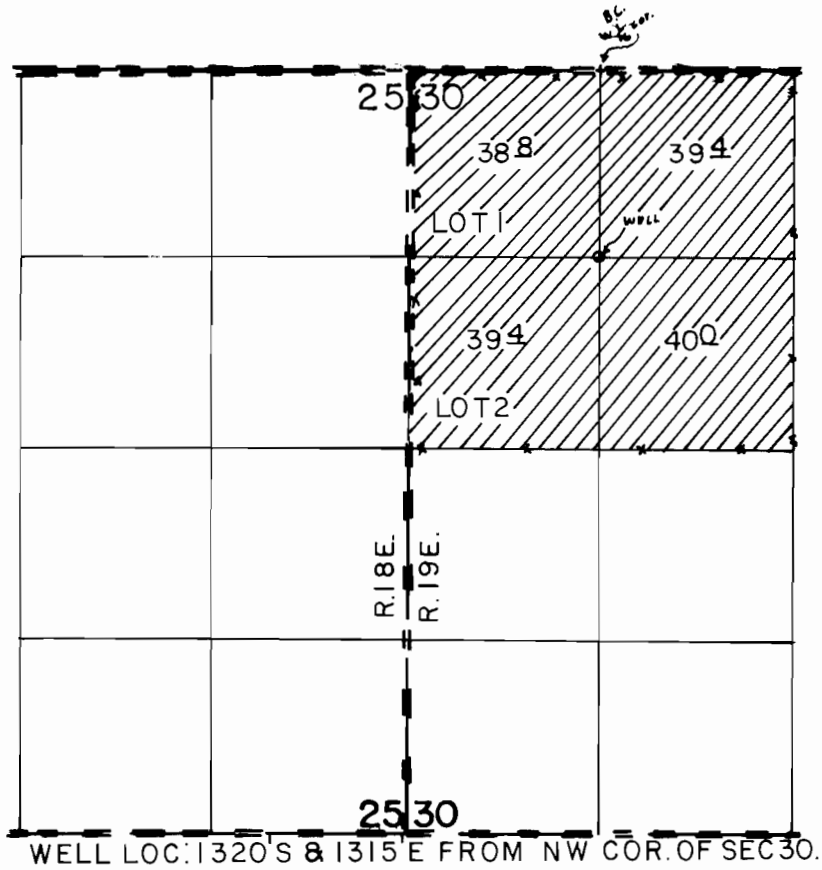

SCALE: 1" = 1320'

FINAL PROOF SURVEY
UNDER

Application No. G-11599 Permit No. G-10806...
IN NAME OF

JERRY L NEWMAN

Surveyed FEB 19... 19.97., by R. SUTTERFIELD