


30 S 8 E Sw. 21 & 15

1:24000

LENZ QUADRANGLE  
OREGON-KLAMATH CO.  
7.5 MINUTE SERIES (TOPOGRAPHIC)

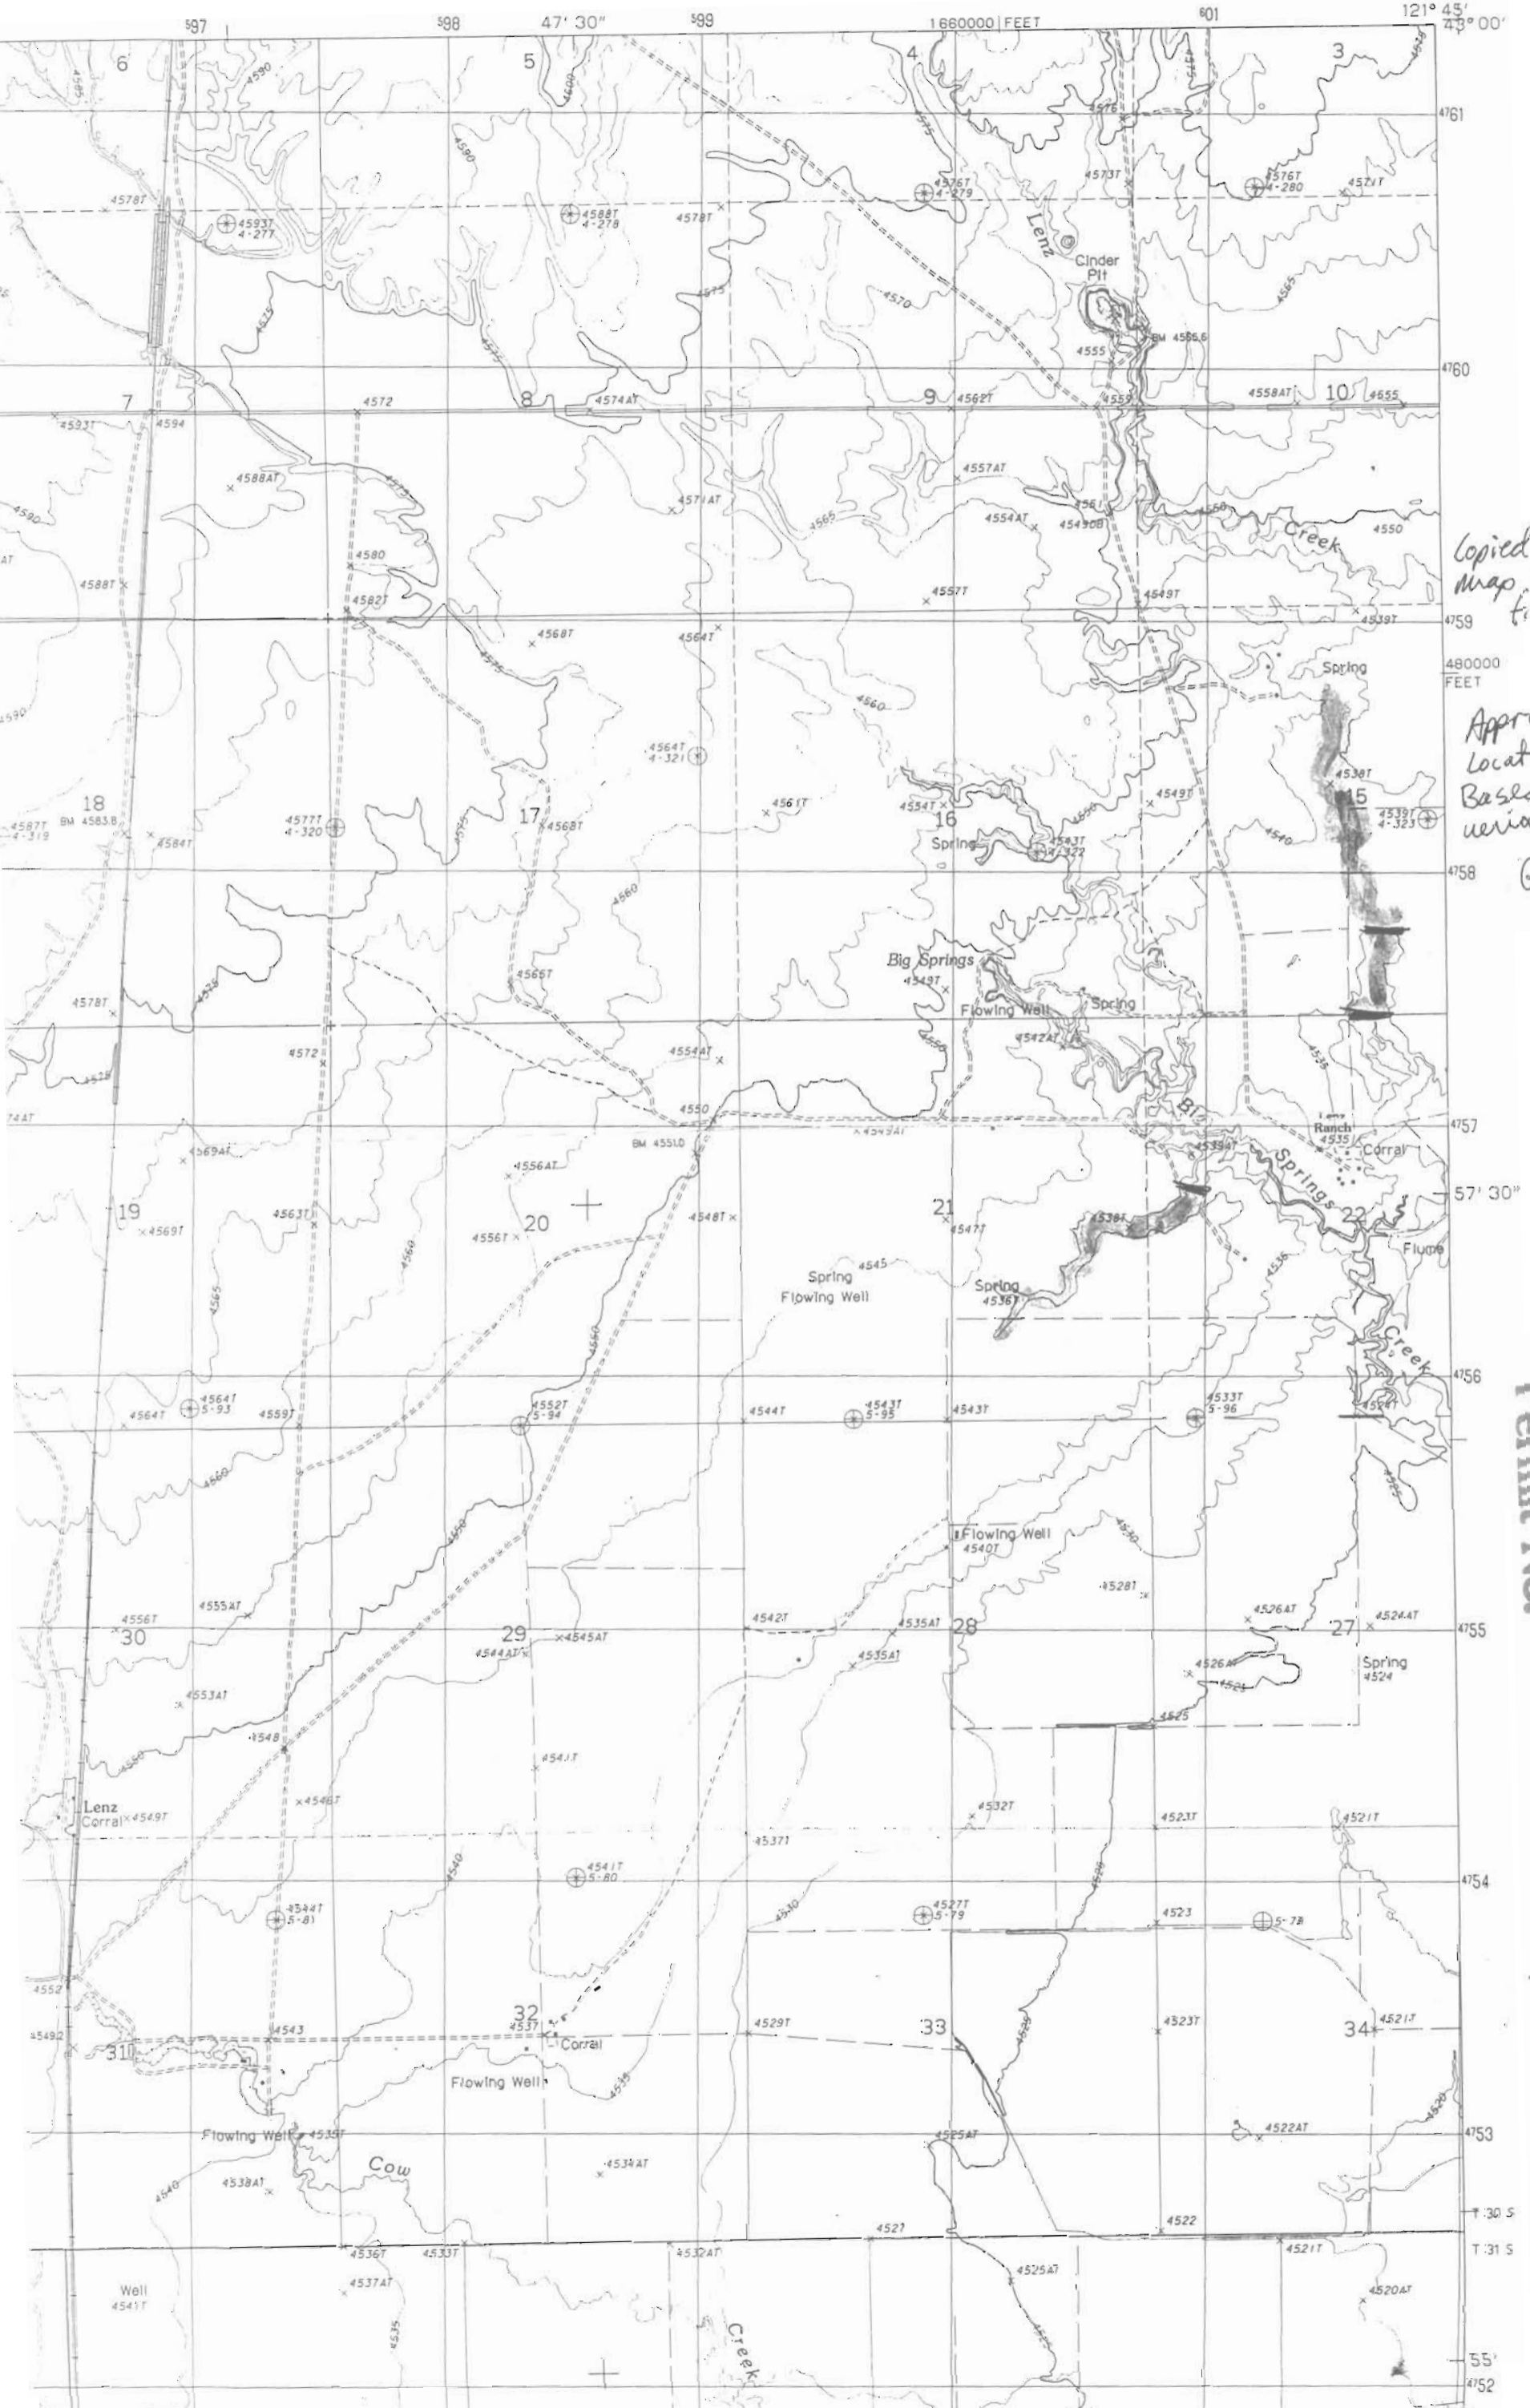

*Copied from  
map on  
file*

*Approx.  
Locations.  
Based on  
aerial photos  
6C  
5-17-95*

**Application No. R-80413**  
**Permit No.**

**75546**  
**#1907**