


T. 2S., R. 5E., W.M.

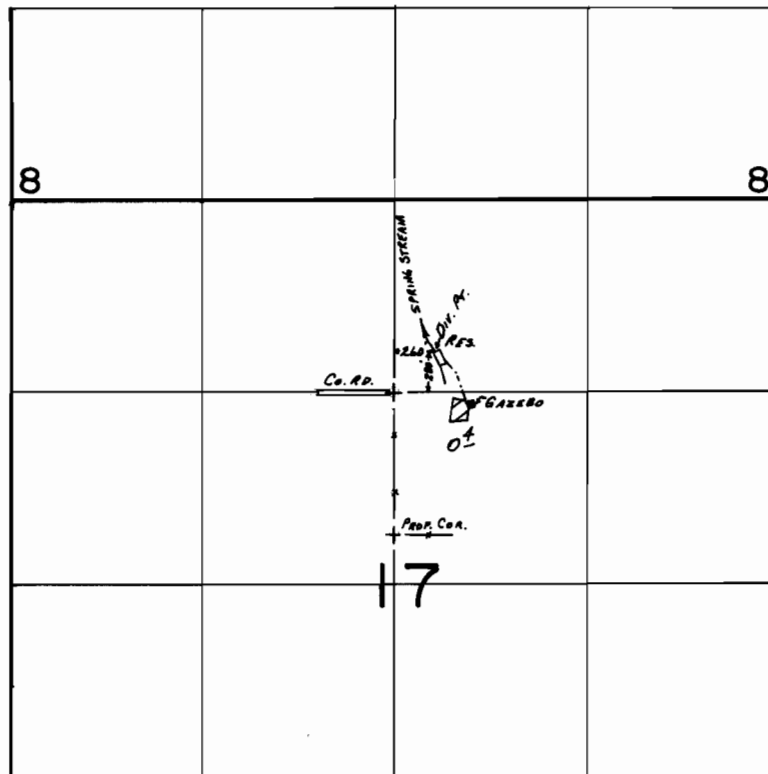

FINAL PROOF SURVEY
UNDER

48076 43930
Application No. R-57840 Permit No. R-7799....
IN NAME OF

THE ORAL HULL FOUNDATION FOR THE BLIND, INC.

Surveyed MAY 9.... 1979., by R.G. MUCKEN....