


T.28&29S.R.12W.W.M.

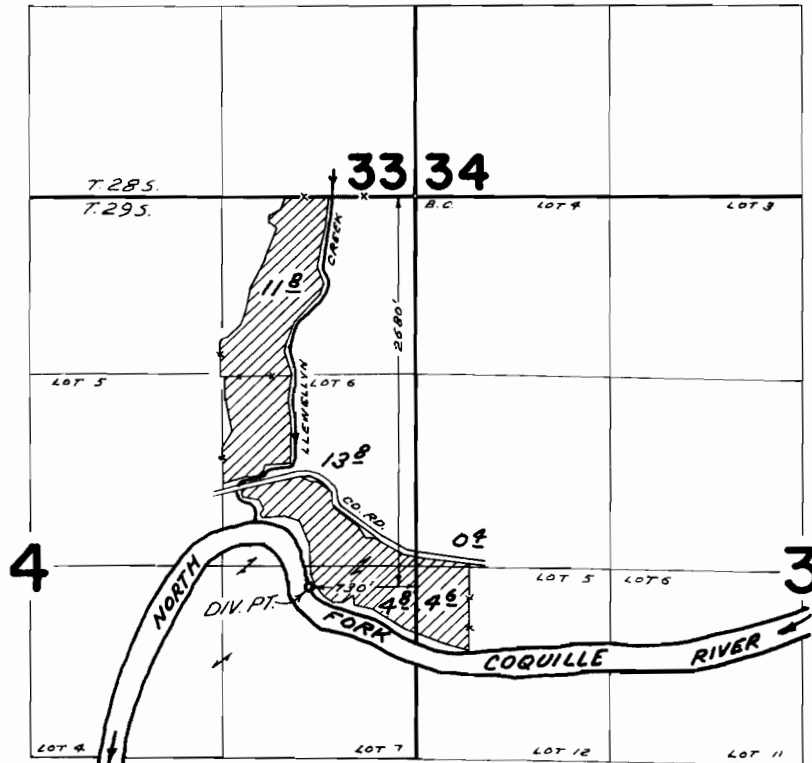

FINAL PROOF SURVEY
UNDER

Application No. 39651 Permit No. 29618
IN NAME OF

ELLIS SOUTHMAYD

Surveyed SEP. 16 1969, by D. BUELL