


T. 2 N. R. 30 E. W. M.

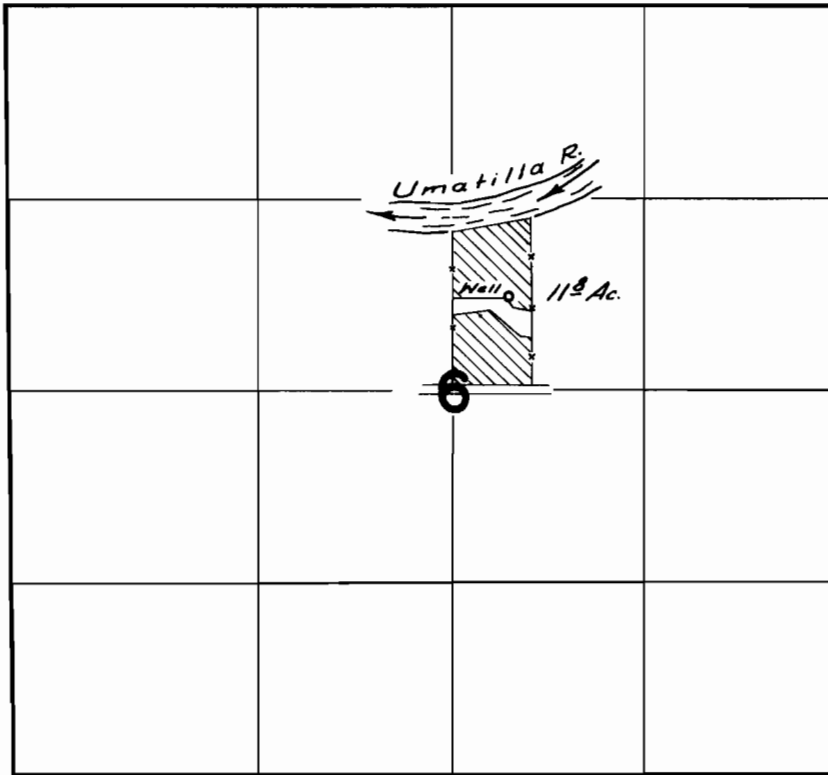

FINAL PROOF SURVEY
UNDER

Application No. *G-1047* Permit No. *G-910*
IN NAME OF

Melvin G. Dick

Surveyed *Sept. 20, 1961*, by *W. B. Burt*