


T.31S., R.15W., W.M.

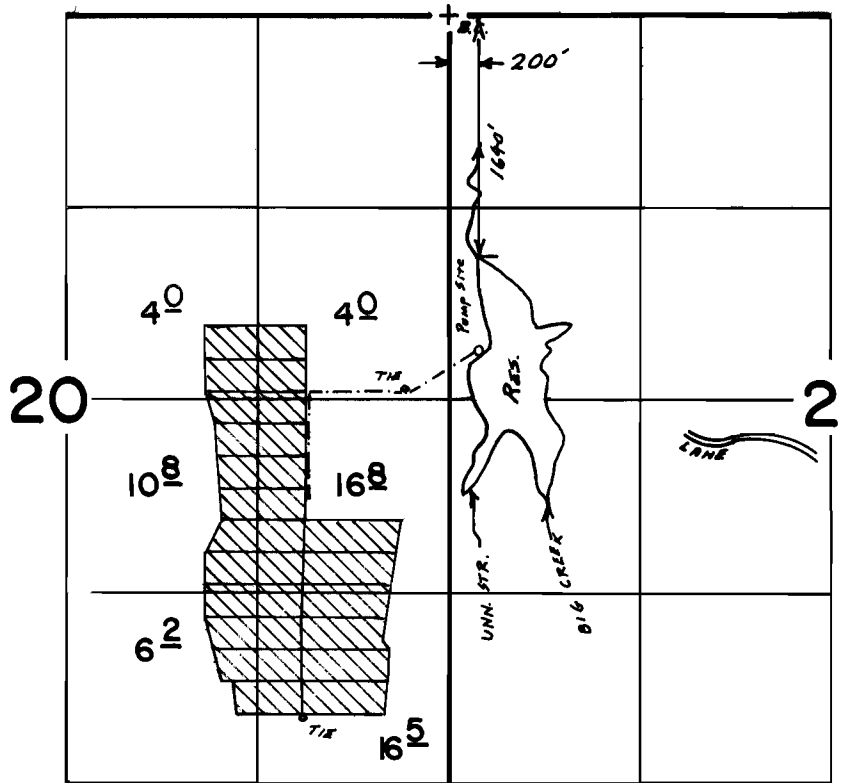

Scale 1" = 1320'

**FINAL PROOF SURVEY**  
UNDER

R-63330 R-8449

Application No. ~~63324~~ Permit No. ~~46806~~  
IN NAME OF

...SEAWINDS... FARMS... INC.....

Surveyed Sept. 15, 1990, by B.S. JAMES....